




AFT BHD NO. 5 TANK (Mechanically Undamaged)  
No. 59

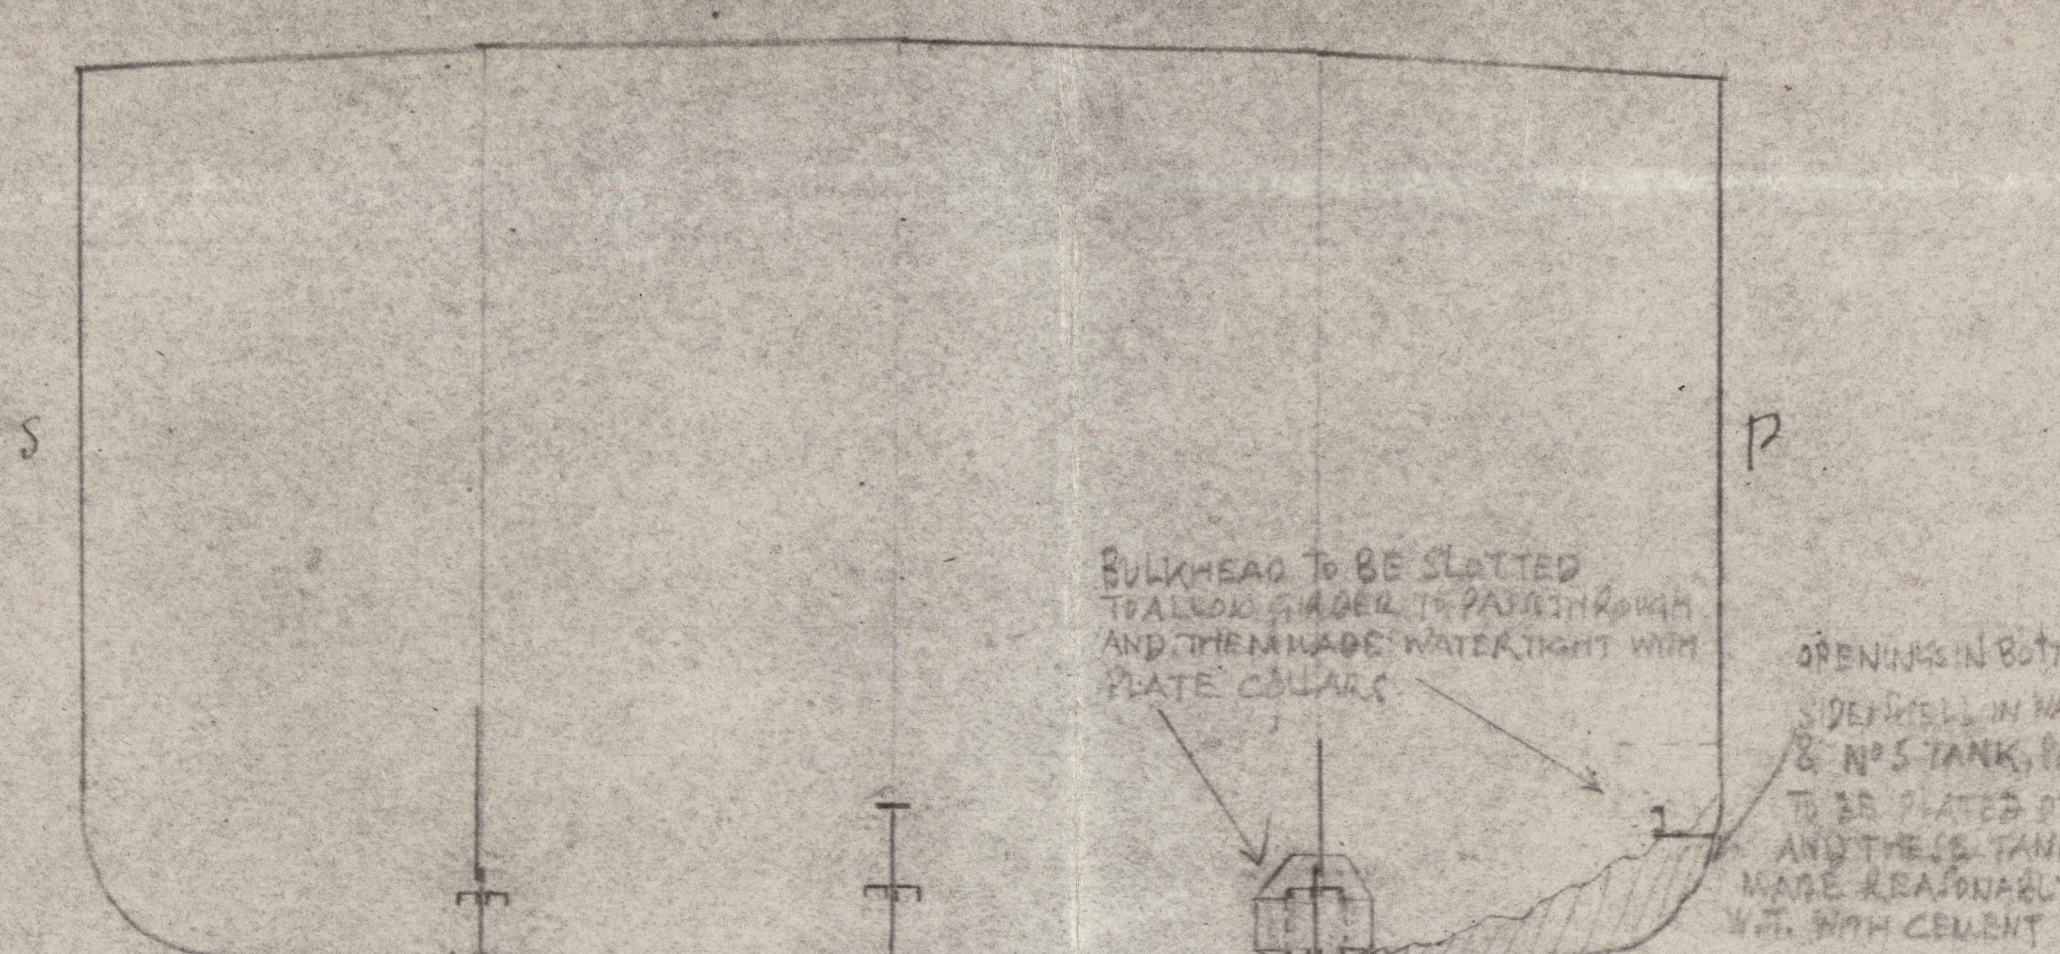


AFT BHD NO. 4 TANK  
No. 62

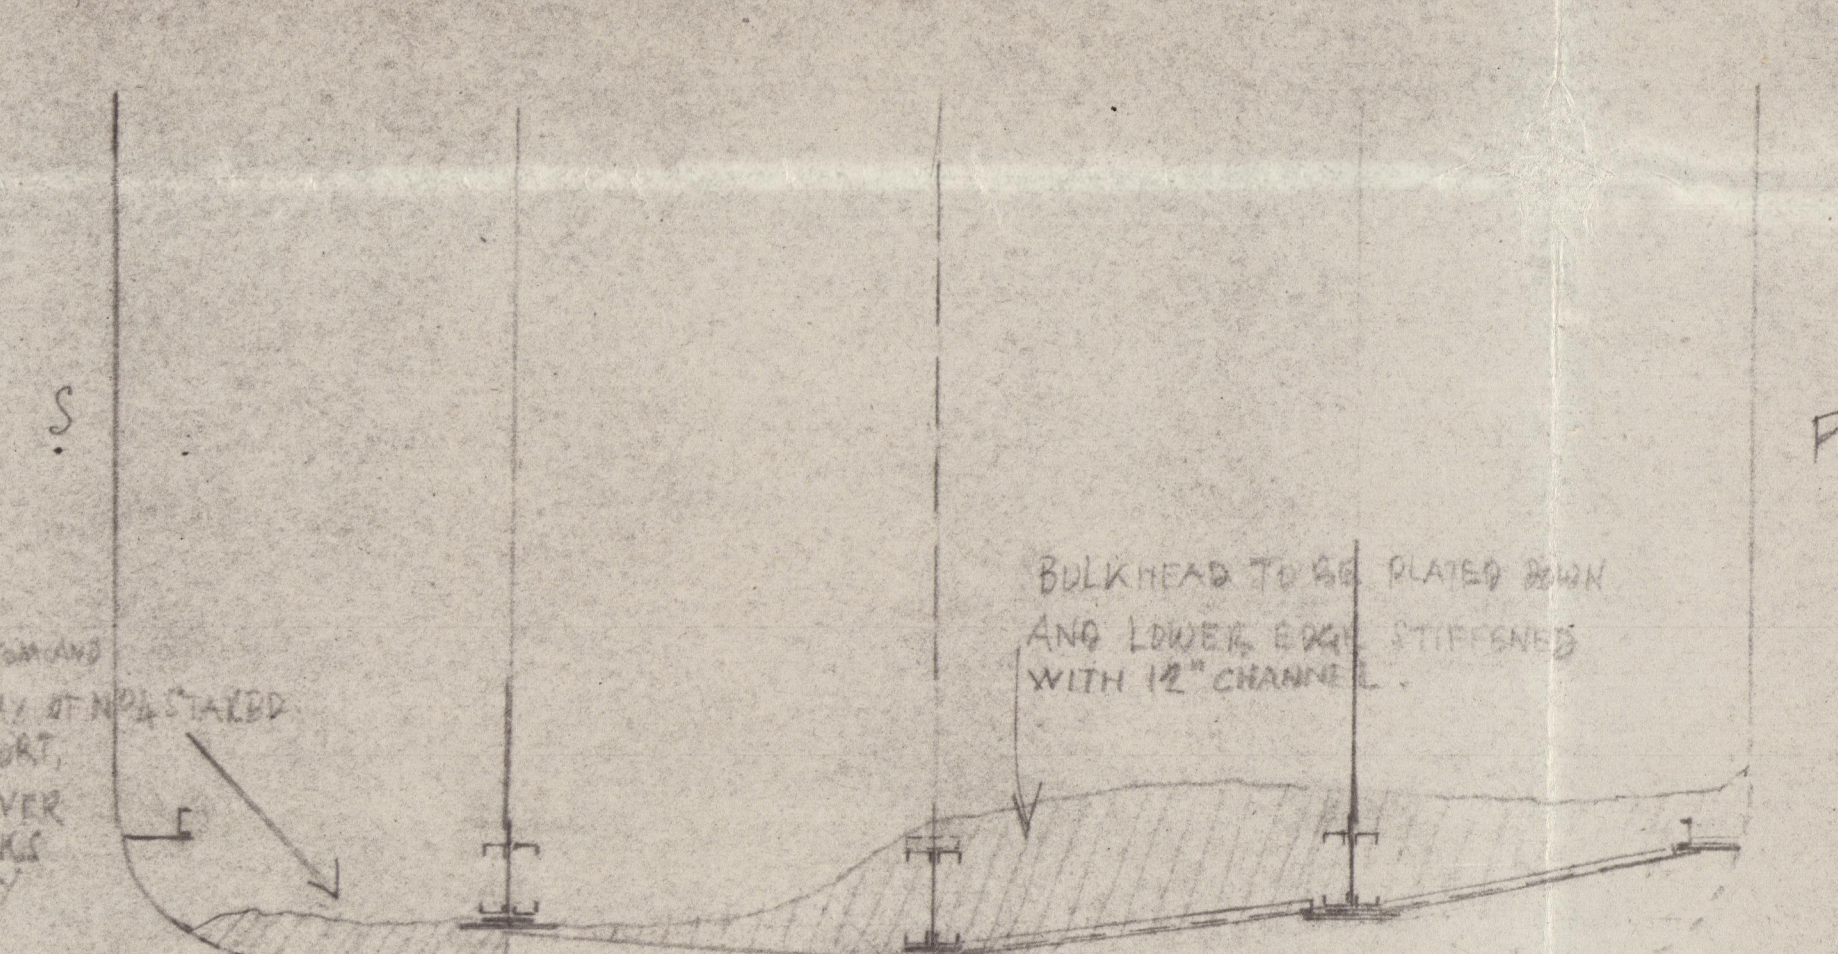


AFT BHD NO. 3 TANK  
No. 65

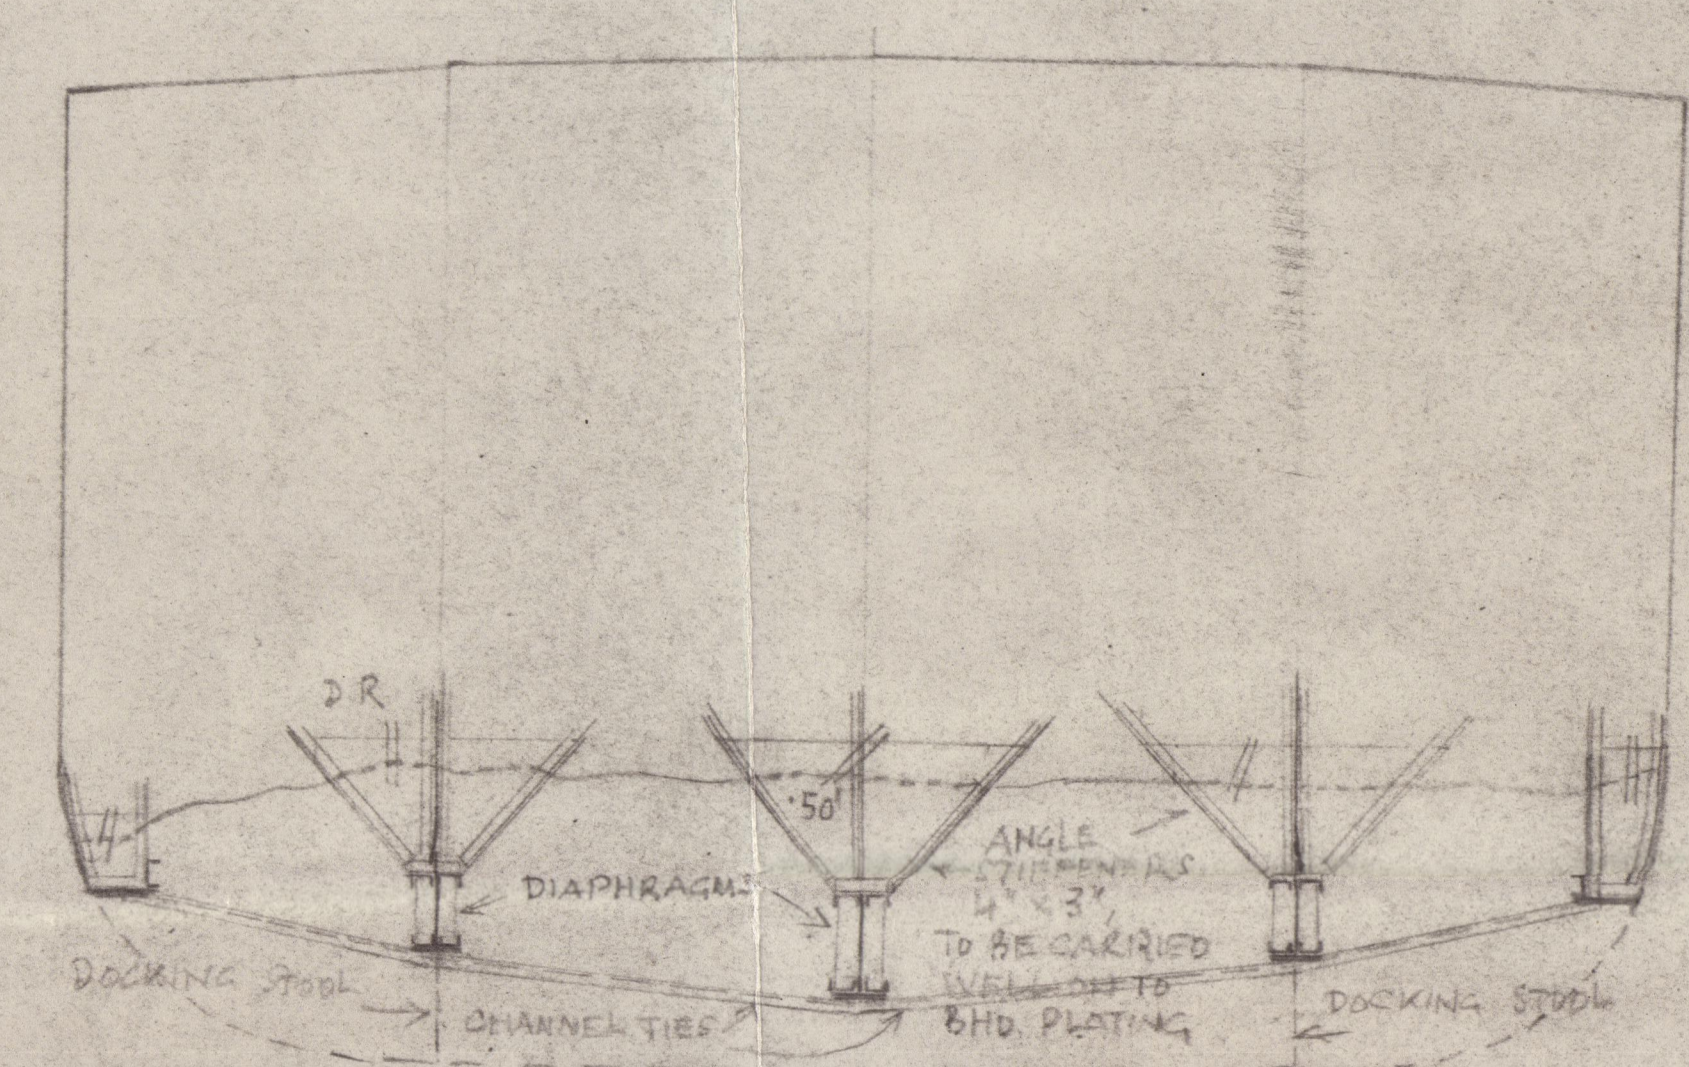

AFT BHD NO. 2  
No. 68 (SEE ALSO DOCKING STOOL PLAN)

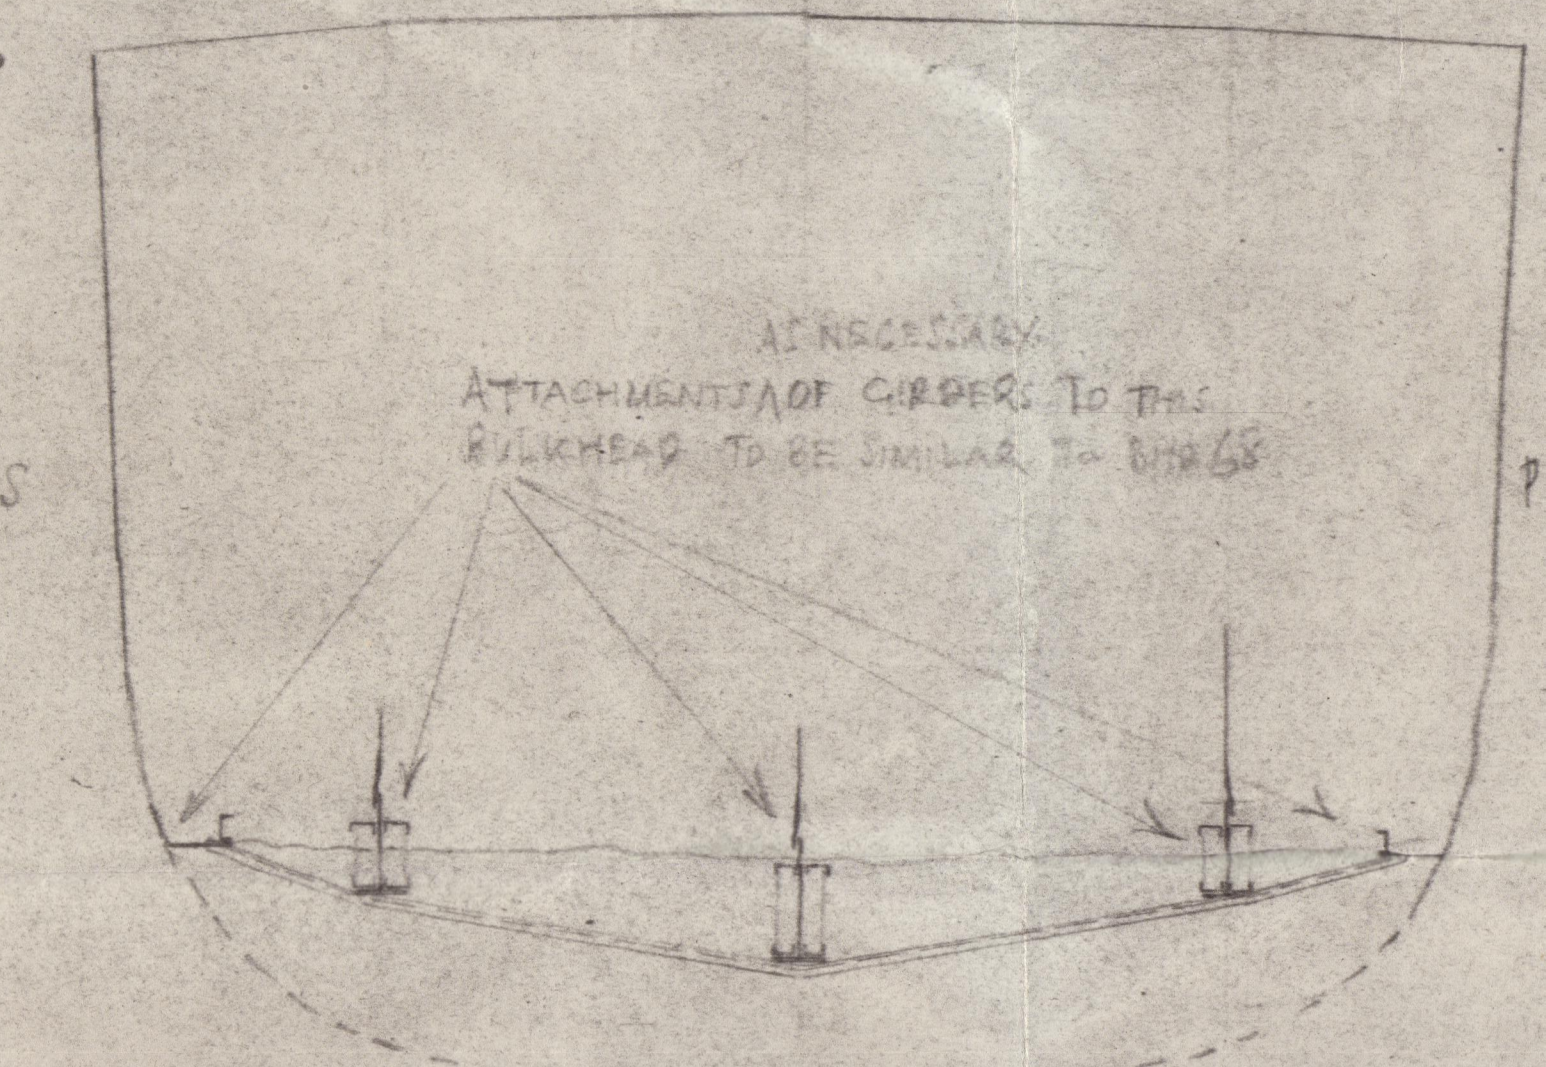


AFT BHD NO. 1  
No. 71

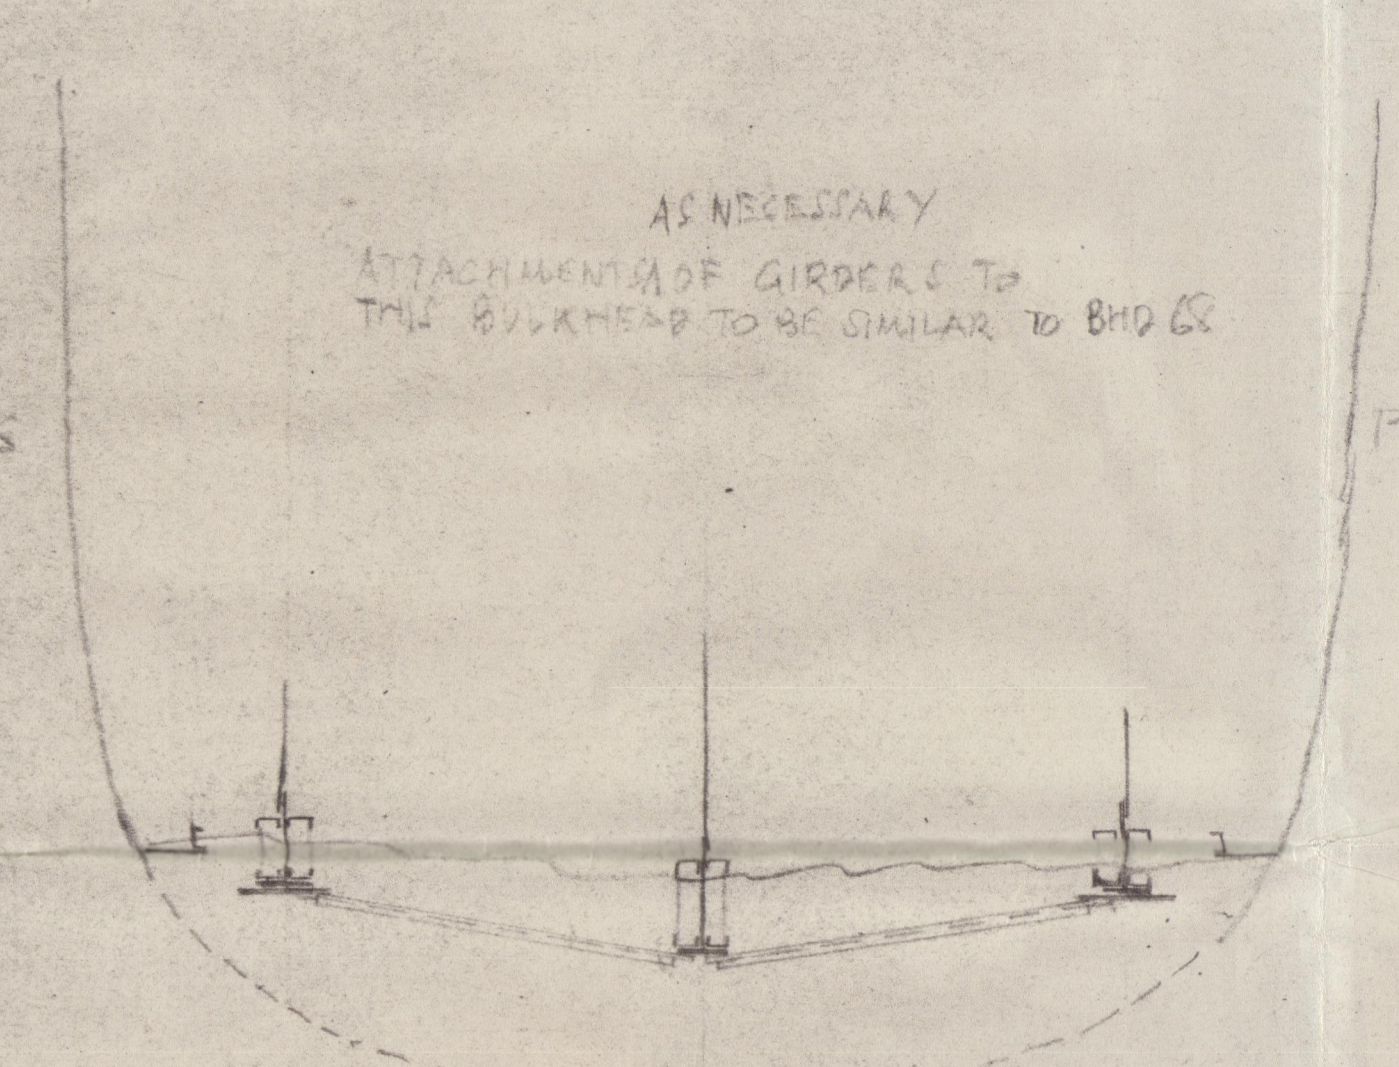

FORE BHD NO. 1  
No. 72

BULKHEAD ON FR. 73 TO BE PLATED DOWN TO NEW LINE OF BOTTOM SHELL AND SUITABLY STIFFENED.

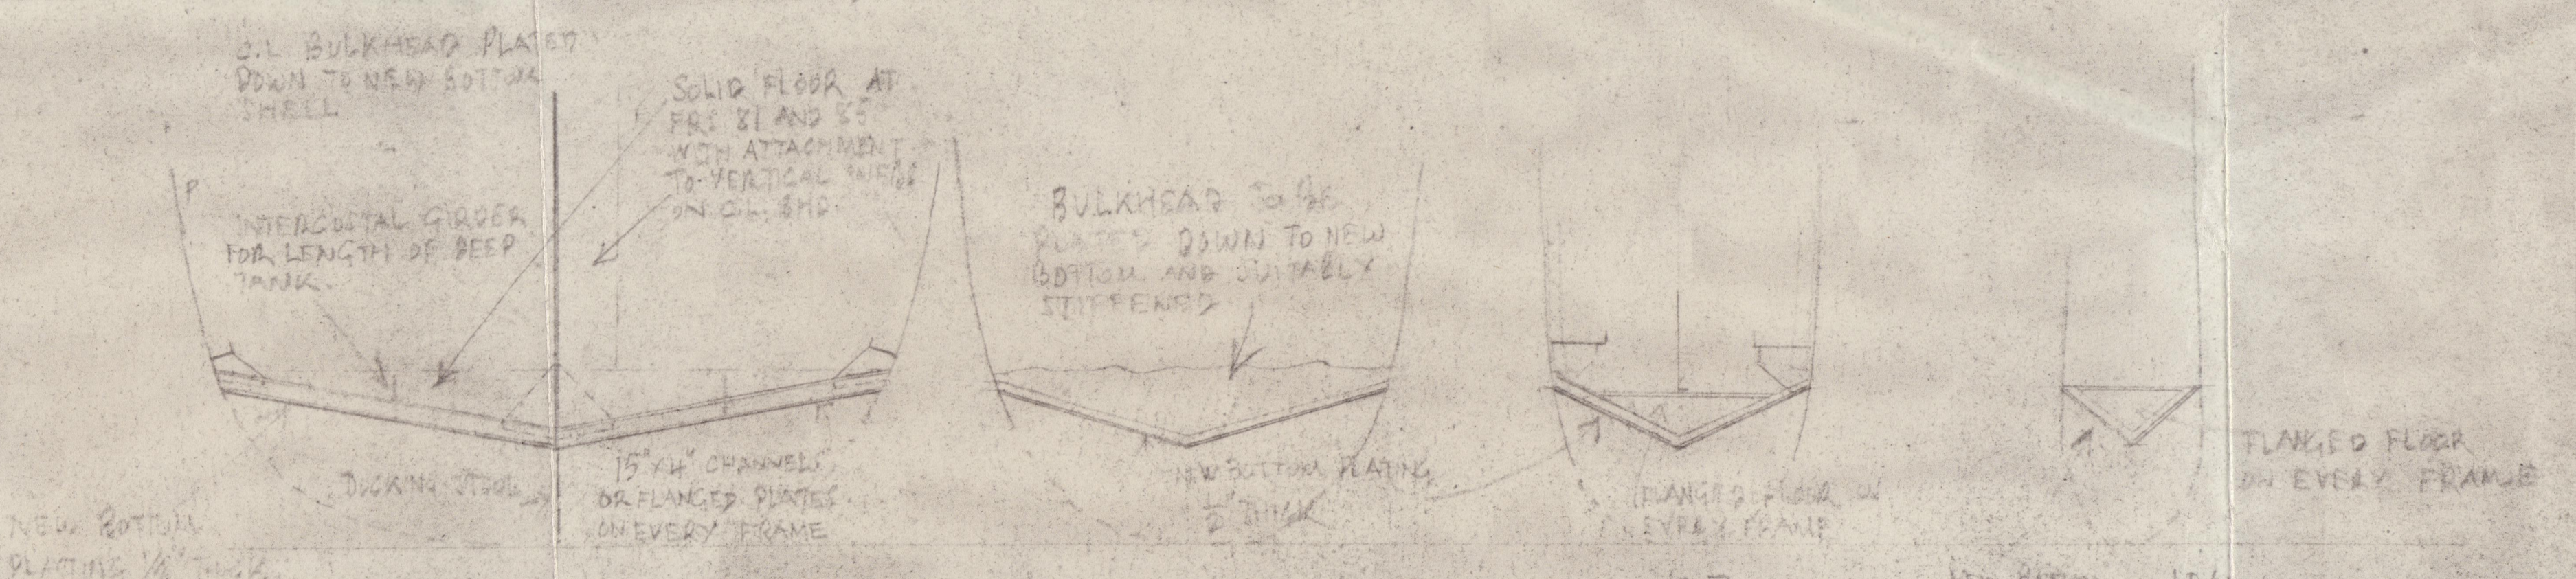

FRS. 74-83.  
SEE ALSO PLAN OF DOCKING STOOL

81  
FORE PEAK BULKHEAD

97

NEW BOTTOM PLATING 1/2" THICK

S/S "MARKAY"  
TEMPORARY REPAIRS REQUIRED BY  
LLOYD'S REGISTER OF SHIPPING  
FOR ISSUE OF INTERIM CERTIFICATE  
FOR VOYAGE IN BALLAST  
TO THE U.S.A.  
SCALE 1/8" = 1 FOOT

*[Signature]*  
17.1.44

NOTE: DETAIL OF ALL ATTACHMENTS  
TO BE ARRANGED TO SURVEYOR'S  
SATISFACTION



W996-0125

*Murkay.*

*Sw. 23461.*



© 2020

Lloyd's Register  
Foundation