Sess. 23467.

SS "MARKAY"

TEMPORARY REPAIRS - AS FITTED.

SEE NOTE ON SHEET 1.

SCALE :- 1/8" = 1 FOOT

3 SHEETS

SHEET - 3.

CARDIFF: WALES DRY DOCK CO. LTD. MARKS
SWANSEA
4 5 44
PALMERS DOCK

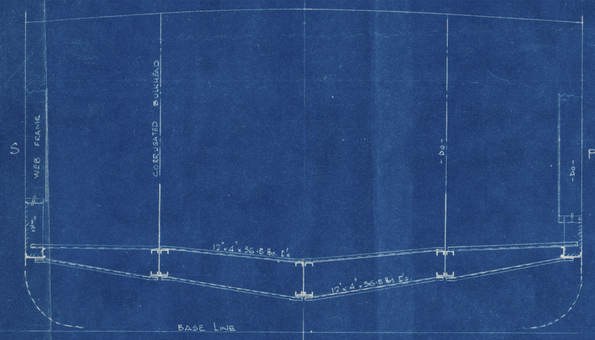

SECTION AT FR. 70 - TYPICAL OF 12" [TIES AT WEB FRAMES.

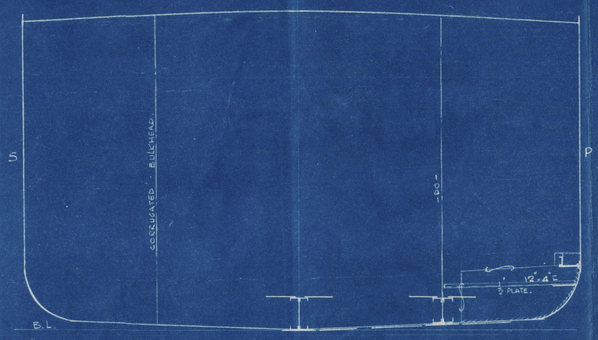

BULKHEAD 62.
LOOKING AFT.

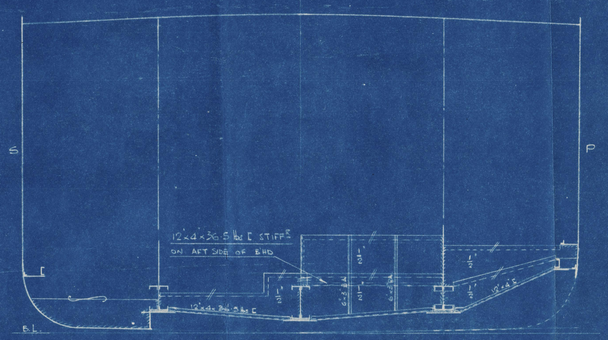

BULKHEAD 65
LOOKING AFT.

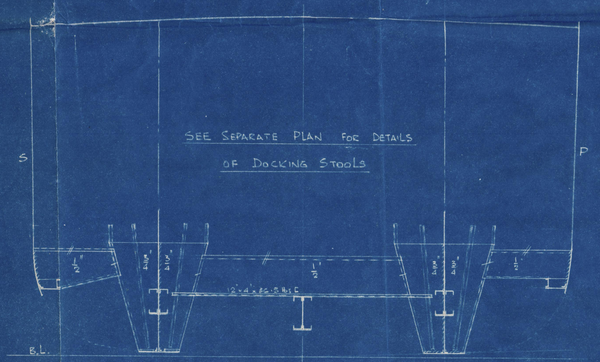

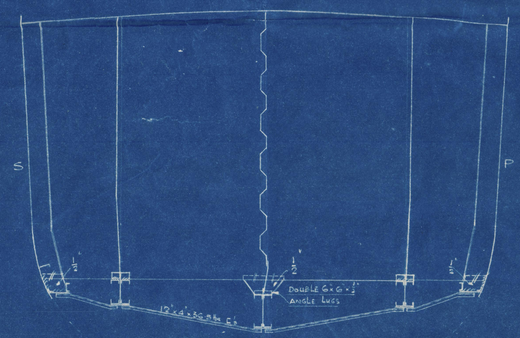

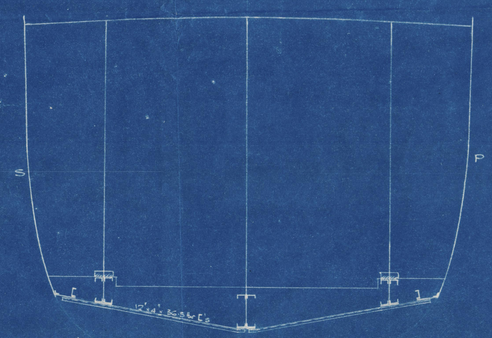

BULKHEAD 68
LOOKING AFT

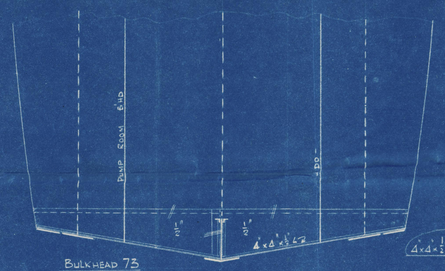

BULKHEAD 73
LOOKING AFT.

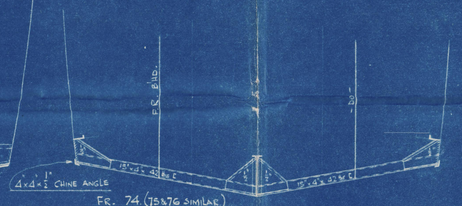

FR. 74 (75 & 76 SIMILAR)
LOOKING AFT.

BULKHEAD 71.
LOOKING AFT.

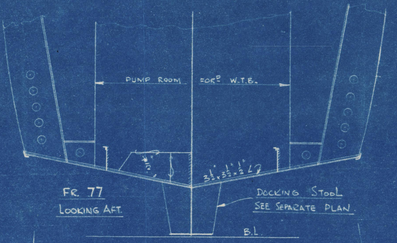

FR. 77
LOOKING AFT.

BULKHEAD 72.
LOOKING AFT.

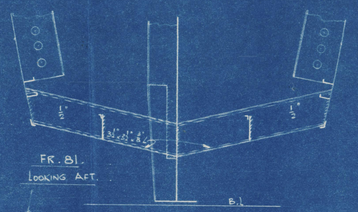

FR. 81.
LOOKING AFT.

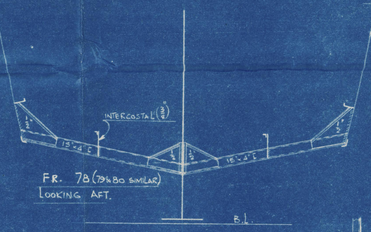

FR. 78 (79 & 80 SIMILAR)
LOOKING AFT.

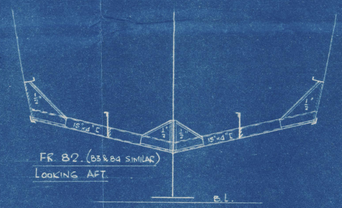

FR. 82. (83 & 84 SIMILAR)
LOOKING AFT.

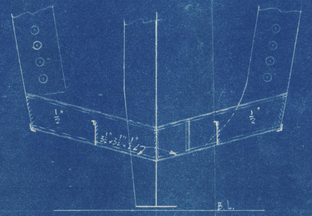

FR. 85. LOOKING AFT.

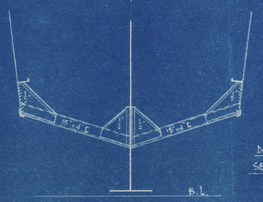

FR. 88. LOOKING AFT.
(86 & 87 SIMILAR)

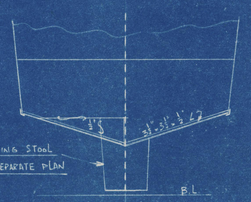

BULKHEAD 89
LOOKING AFT

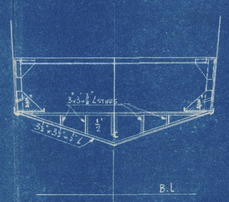

FR. 90. LOOKING AFT.
EVEN NO. FRAMES 90-102 SIMILAR

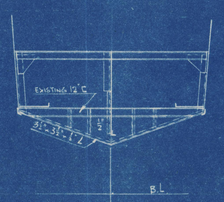

FR. 91. LOOKING AFT.
ODD NO. FRAMES 91-103 SIMILAR

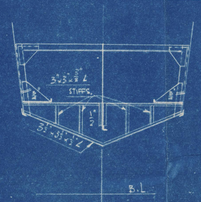

FR. 94. LOOKING AFT.

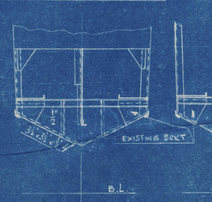

FR. 97. LOOKING AFT.

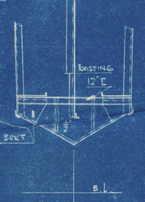

FR. 99. LOOKING AFT

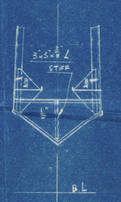

FR. 102.

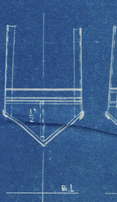

FR. 103

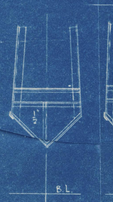

FR. 104

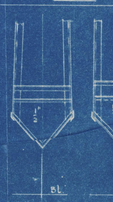

FR. 105.

FR. 106.

© 2020 Lloyd's Register Foundation
WEB 012.2