

29.11.13
9.12.13
23.12.13
31.12.13
5.1.14
3.2.14
31.3.14
22.4.14
21.5.14

N^o 306

MIDSHIP SECTION.

T.S.S. 220'-0" x 35'-0" x 12'-8" MLD. AMIDSHIPS.

SCALE $\frac{1}{2}$ " = 1 FOOT.

100 A. I. SHADE DECK CLASS

DIMENSIONS.

LENGTH	220'-0"	1 st N ^o B + D = 97.68.
BREADTH	35'-0"	2 nd " (B + D) L = 10,485.
DEPTH	12'-6"	PROPORTIONS $\frac{220}{20.76} = 10.91$

EQUIPMENT.


(B + D) L = 10485
SHADE DECK 1237
FORECASTLE & HOUSES 629

12351 EQUIPMENT N^o

2 BOWER ANCHORS	-	25½ CWTs STOCKLESS
1 " " "	-	22 " "
1 STREAM " "	-	8½ " "
1 KEDGE " "	-	4¾ " "
220 FATHS	-	1½" CABLE
75 " "	-	15" STREAM CHAIN OR 3½" STEEL WIRE
90 " "	-	10" TOWLINE = 3½" " "
90 " "	-	6" HANSER
90 " "	-	5" WARR

RIVETING

BUTTS OF ALL SHELL PLATING & SHADE DECK STRINGER LAPPED & TREBLE RIVETED FOR $\frac{1}{2}$ L. AMIDSHIPS, DOUBLE BEYOND.
" OF FLOOR PLATES LAPPED & DOUBLE RIVETED
" " FLAT PLATE KEEL TREBLE THROUGHOUT.
" " MAIN DECK STRINGER & TIE PLATES LAPPED & DOUBLE RIVETED
" " SHADE DECK PLATING LAPPED & DOUBLE RIVETED FOR $\frac{1}{2}$ L. SINGLE AT ENDS.
EDGES OF DECK PLATING ALL SINGLE RIVETED.

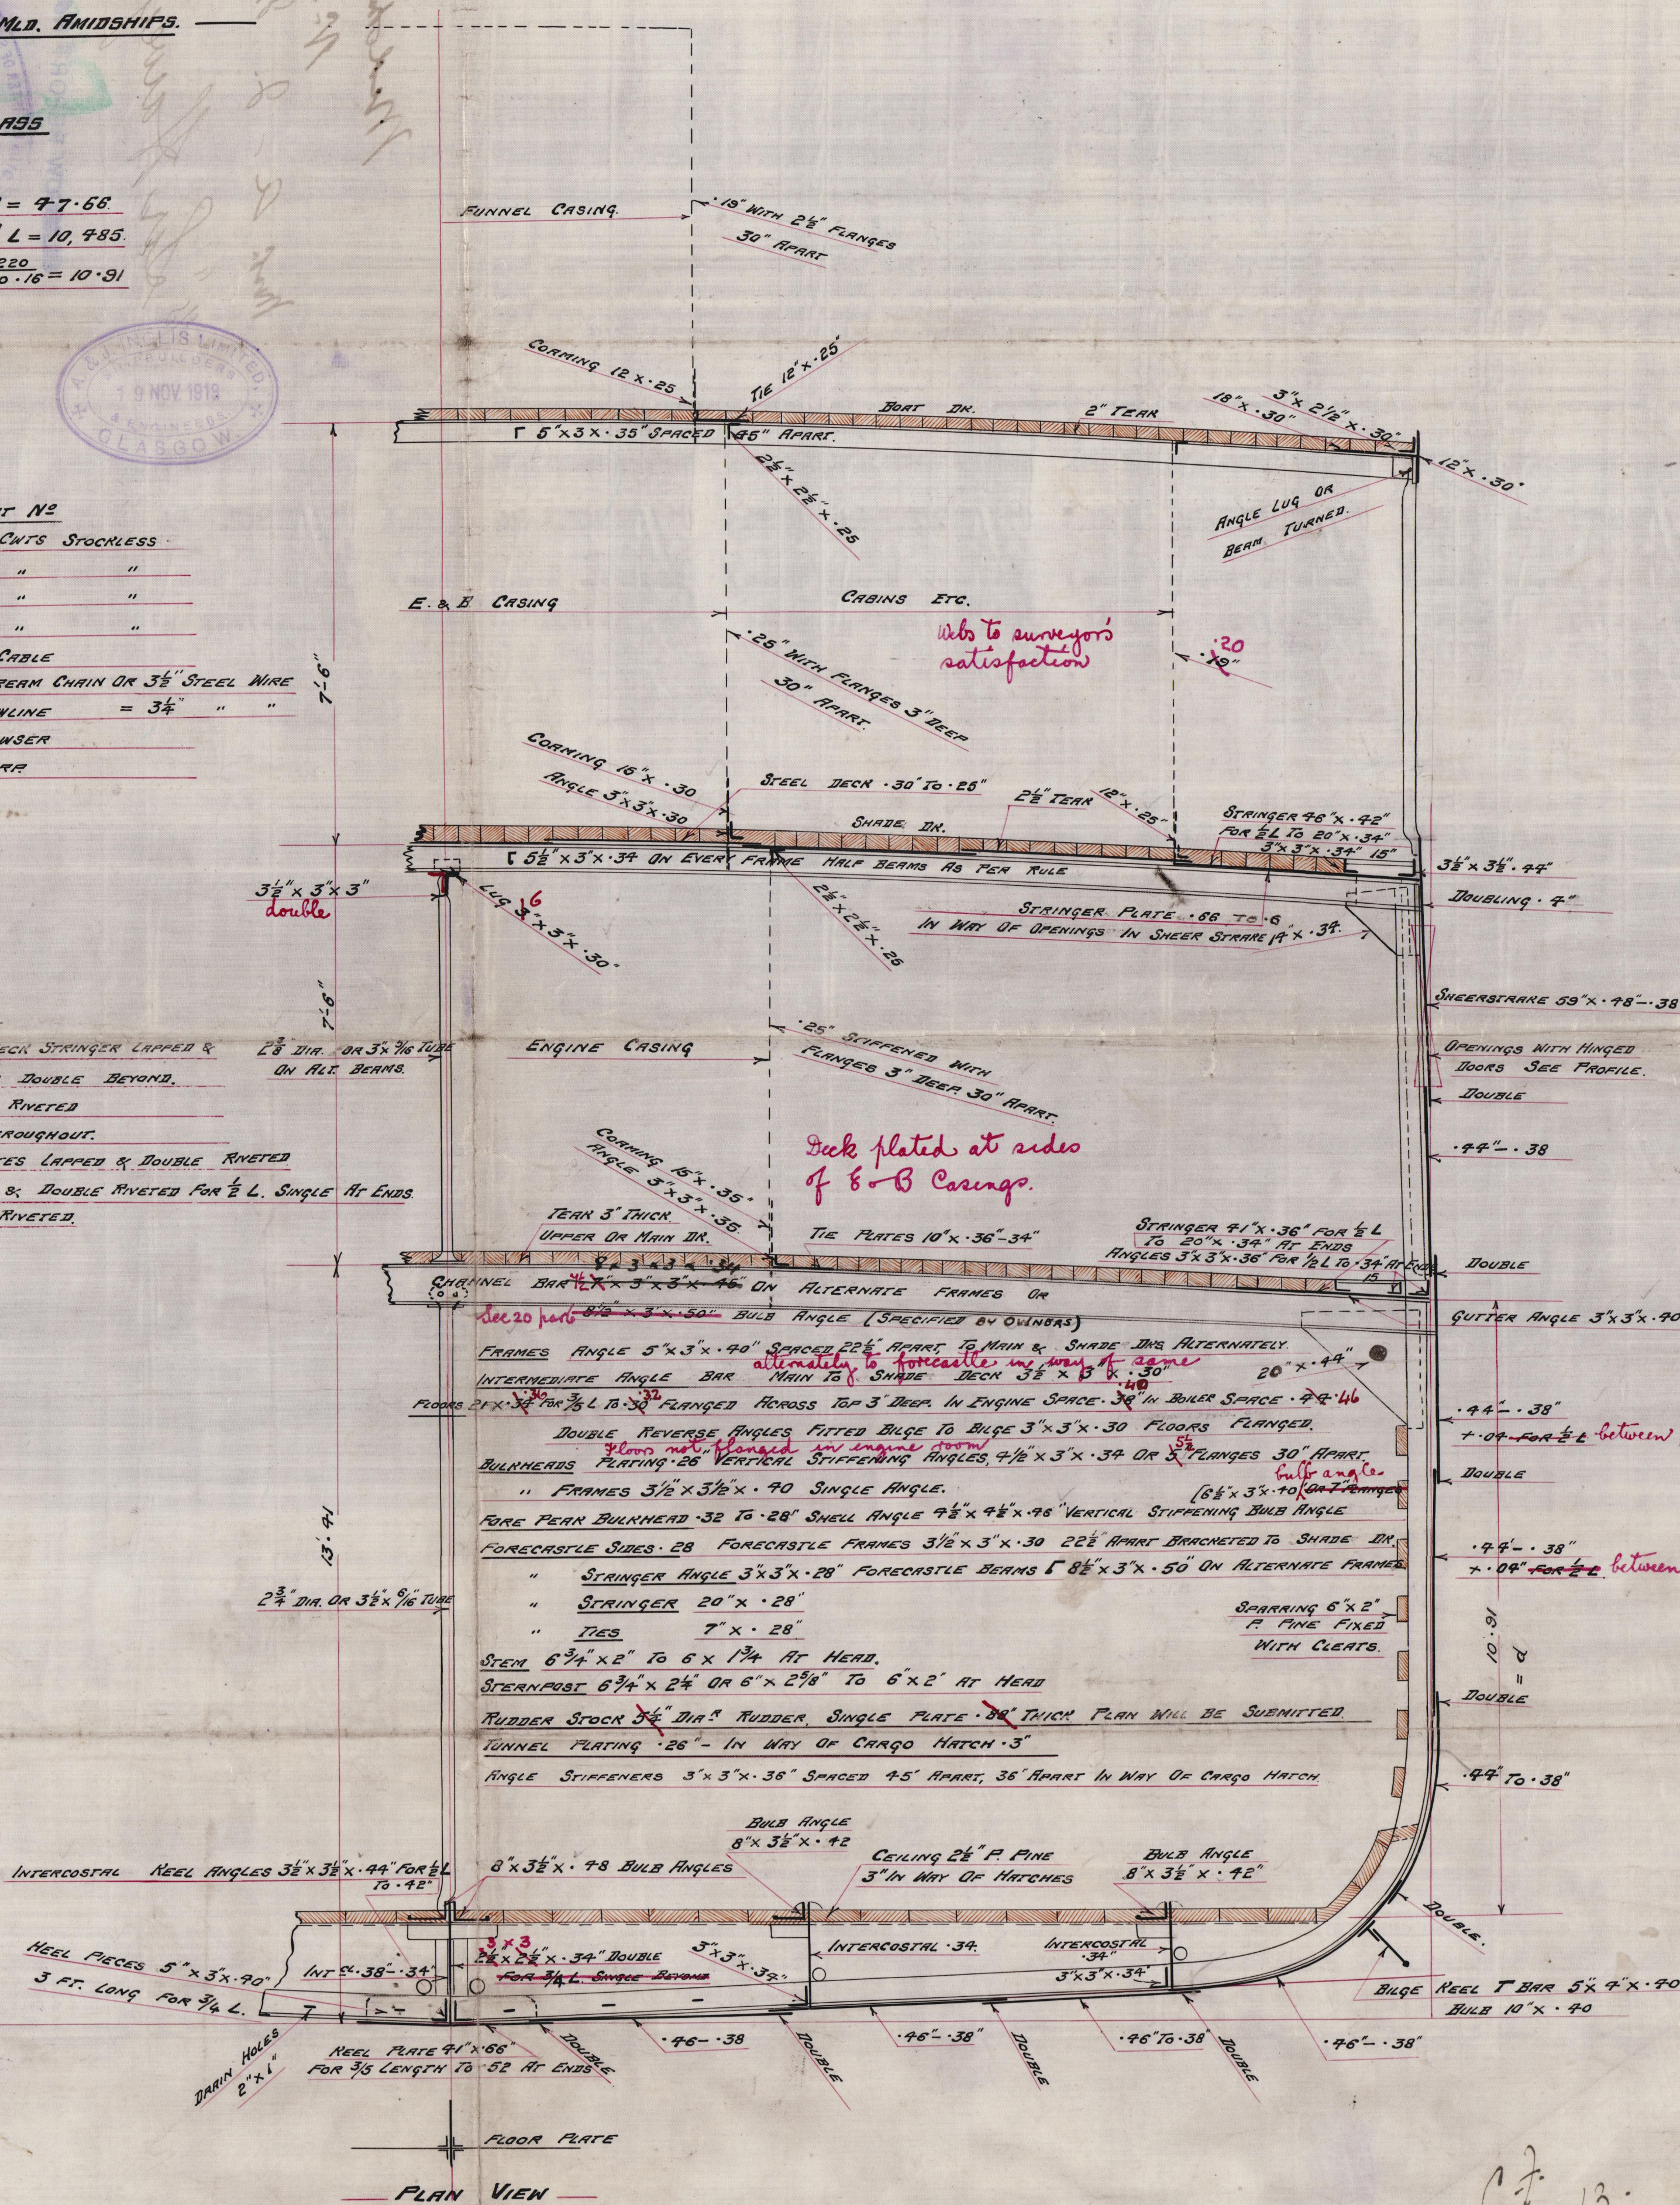



N^o 306.

Mrs. A - J. Inglis Ltd

1/8 "Sir Harvey Adams & Co.

GLASGOW REPORT No 34629



W996-0267



© 2020

Lloyd's Register
Foundation