

16.11.14

PLAN No. 4942.
FOR ENCLOSURE TO
MESSRS LLOYDS SURVEYOR
HULL. FROM
COCHRANE & SONS, LTD.
SHIPBUILDERS, SELBY
DATE 12/11/14

MIDSHIP SECTION

STEEL SCREW TRAWLER

— No 636 —


136' 8" B.P. x 23' 6" EX. x 13' 7" MOULDED

SCALE 1/2" = 1 FT.

TO CLASS 100.A.I. STEAM TRAWLER

DECK PLATED OVER IN WAY OF MACHINERY

ENGINE AND BOILER CASING AS PREVIOUSLY APPROVED

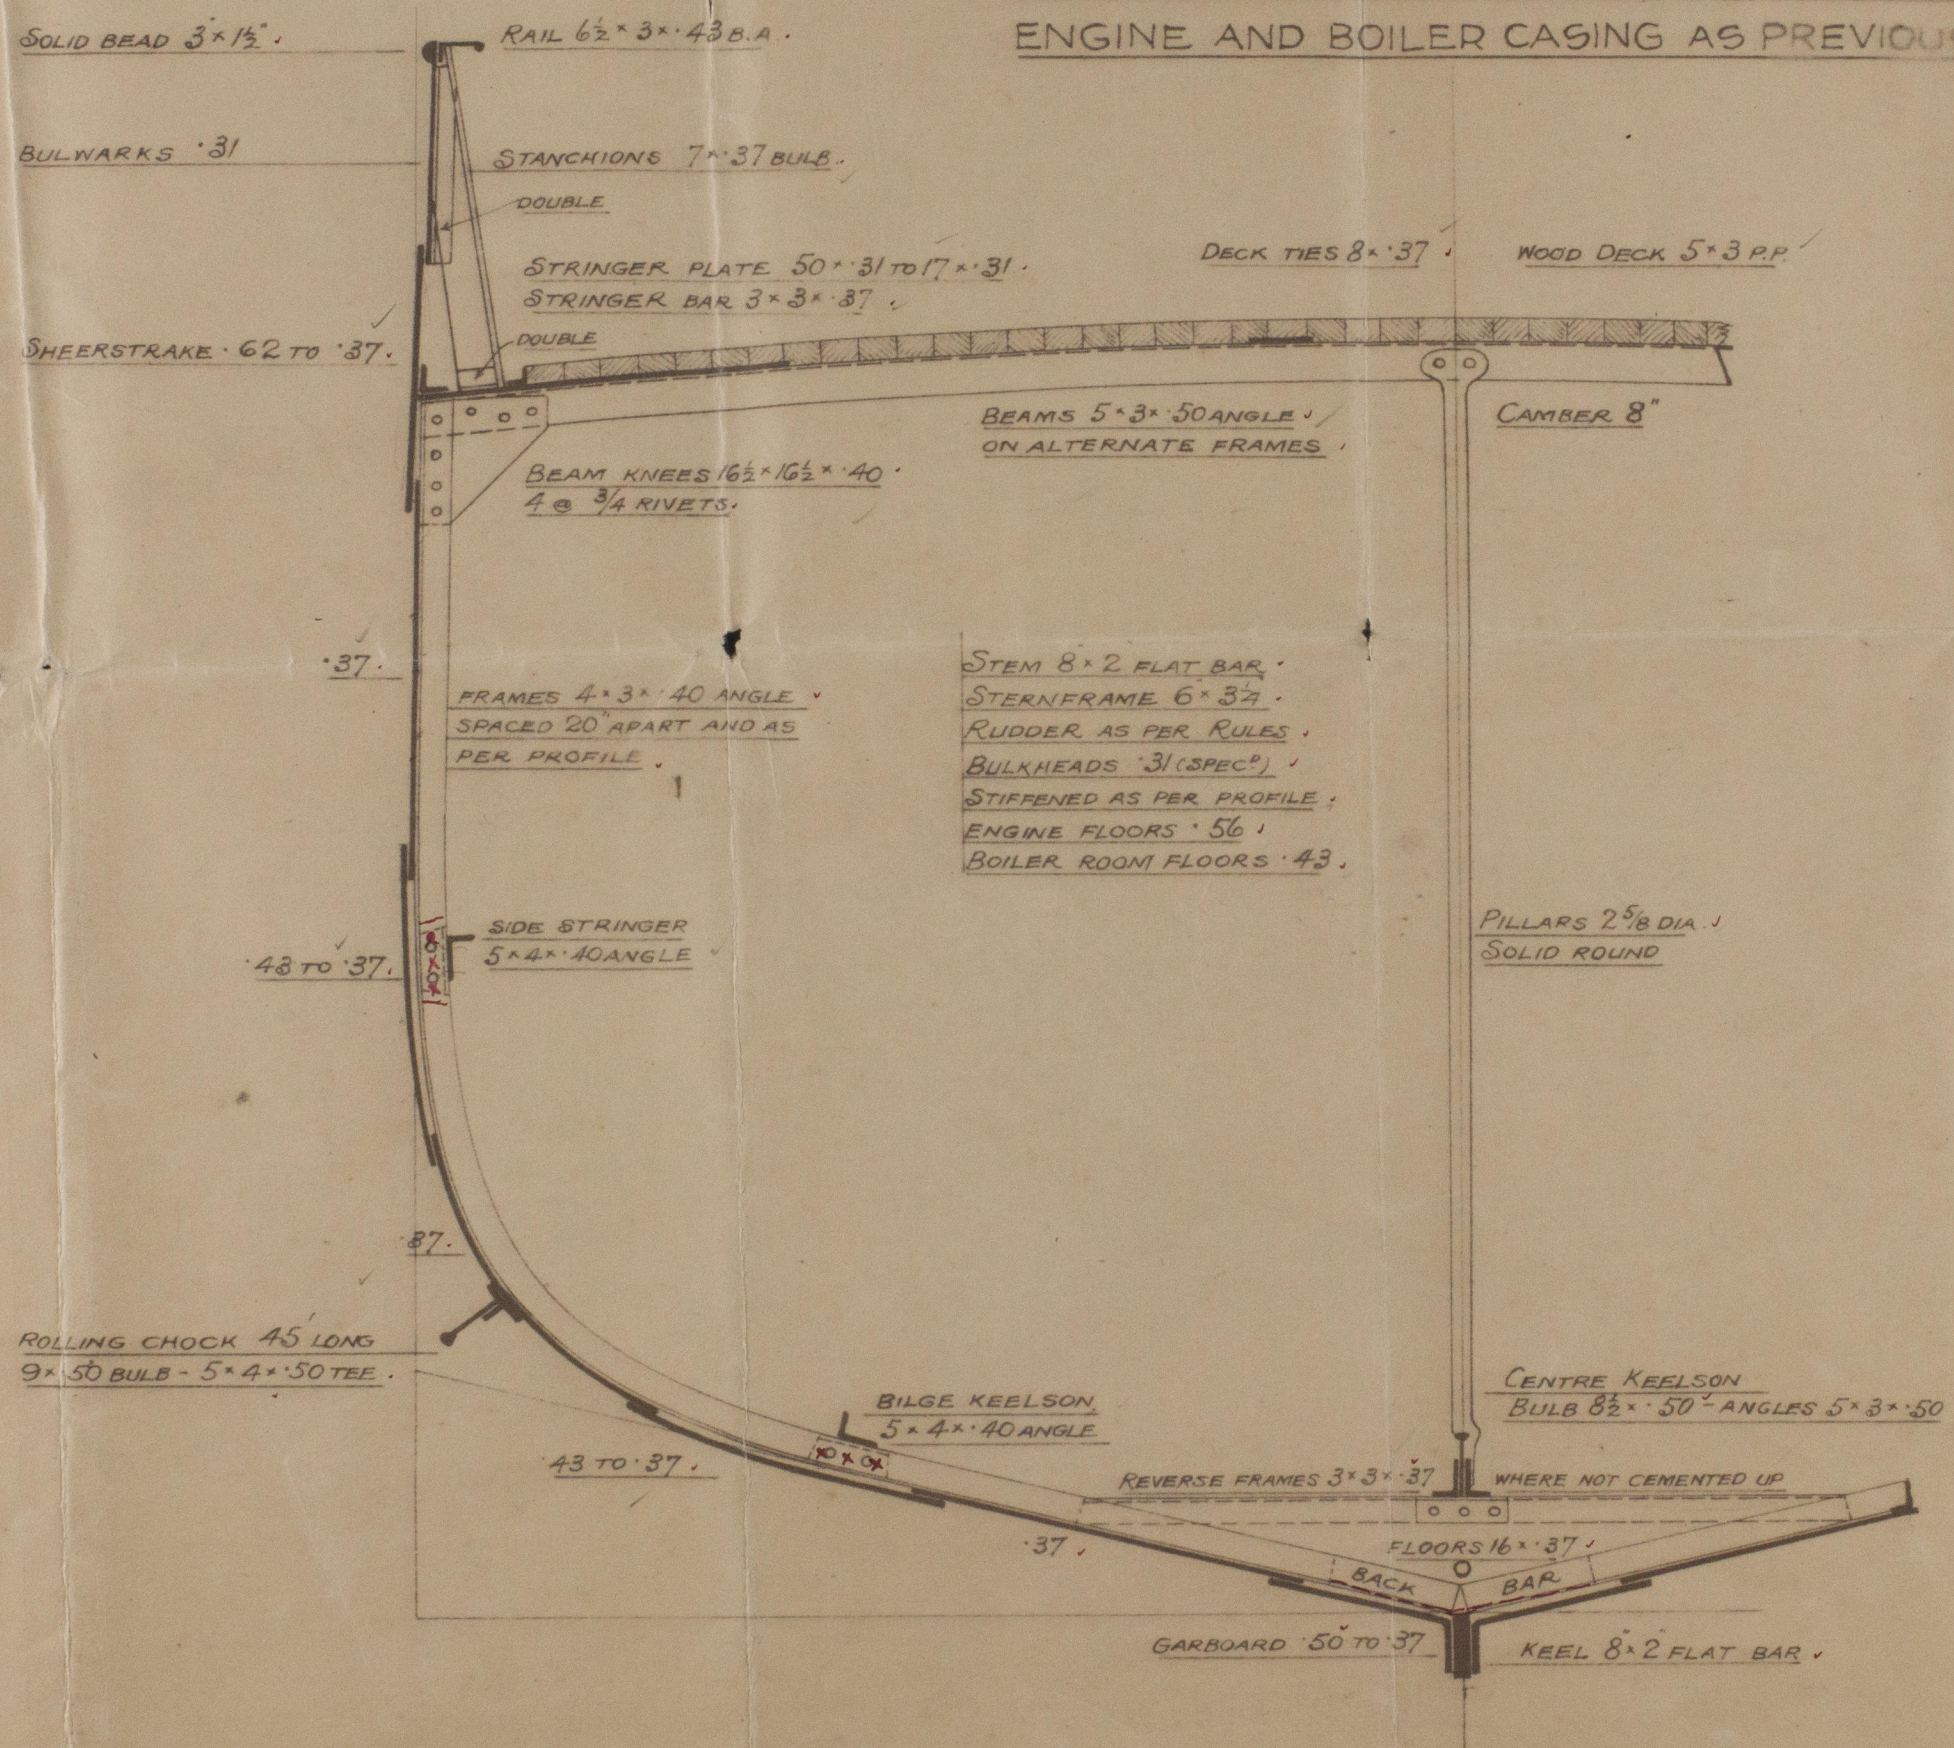

NUMERALS

$B+D = 36.95 - L \times (B+D) = 5049$

PROPORTIONS

$\frac{L}{B} = 5.84$
 $\frac{L}{D} = 10.06$

EQUIPMENT

1ST BOWER ANCHOR 8 CWTs - STOCKLESS
2ND " " 7 1/2 " "
KEDGE " 3 1/4 " EX STOCK
120 FMS. 1 1/16" STUD CHAIN CABLE
60 " 6 HAWSER
60 " 5 WARP

RIVETTING

BUTTS OF SHELL PLATING TO BE LAPPED
AND DOUBLE RIVETTED EXCEPT GARBOARD AND
SHEERSTRAKE WHICH ARE TO BE STRAPPED
AND DOUBLE RIVETTED
LANDINGS DOUBLE RIVETTED EXCEPT BULWARK
LANDING WHICH IS TO BE SINGLE

16.11.14



© 2020

Lloyd's Register
Foundation

W997-0078



Cochranes b36

Mudrif Lechi

"Dhoon" ex.

S.S. "Armageddon" Hull Rpt dtd

28567

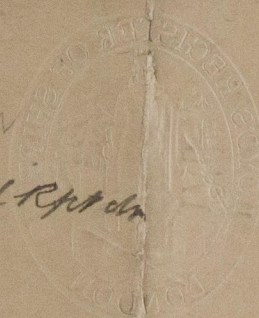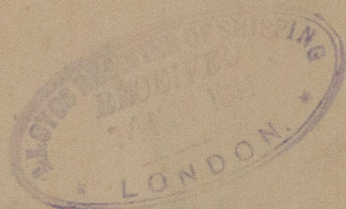

RETAIN



© 2020

Lloyd's Register
Foundation