

# Lloyd's Register of Shipping.

(Report on Vessel No. \_\_\_\_\_ Port \_\_\_\_\_)

## No. \_\_\_\_\_ SHIP FORGINGS ~~OR CASTINGS~~.

I have to report that the undermentioned ~~Iron or Steel Forgings or Castings~~, manufactured by Hessers Burgerhout & Scheepsw. of Rotterdam for the Vessel No. 800, being built by Hessers. Gebr. Pot. of Bolnes — have been inspected by me as set forth below and found to be, so far as can be seen, sound and free from defect.

STERN. FRAME  
Mark on Forgings or Castings.

RUDDER FORGING

TILLER  
FORGING

Lloyd's  
No. 233  
M.J. 26-1-28


LLOYD'S  
N 234  
M.J. 26-1-28

LLOYD'S  
N 236  
M.J. 26-1-28

Rotterdam 3/2-28-  
H. J. Jonker.

	STERN FRAME.	RUDDER FRAME.	STEM. TILLER
Material*	Siemens Hartin Steel	Siemens Hartin Steel	Siemens Hartin Steel
How made	Forged	Forged	Forged
If annealed	yes	yes	yes
Dimensions	as per plan	as per plan	as per plan
Progress on Inspection	Forged & mach.	Forged & mach.	Forged & mach.
Date when Inspected	28/12-27 4.11-17-18-26/1-28	14-11-17-18-26/1-28	17-18-26/1-28
CASTINGS.			
Tests on Standard Test Pieces.			
Tensile Test—			
Tons per square inch	25 1/2 to 26 Tons	32 Tons	27 1/2 Tons
Extension per cent.	35 to 36 %	35 %	30 %
Cold Bending Test—			
Angle before fracture	180° good	180° good	180° good
Drop Test—			
Height from ground	✓	✓	✓
Hammering Test—			
If made according to Rules and found satisfactory	✓	✓	✓

SKETCHES OF FRAMES SHOWING POSITION AND DESCRIPTION OF WELDS OF FORGINGS.

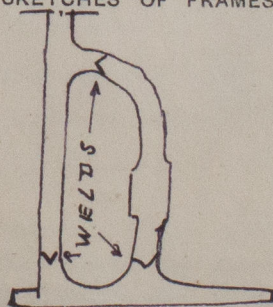

Fee (if any chargeable) £ : :  
To be paid at Rotterdam

\* If of Iron, state whether scrap or puddled Iron. If of Steel, state whether made on the Open Hearth process.