


Nos from forward.

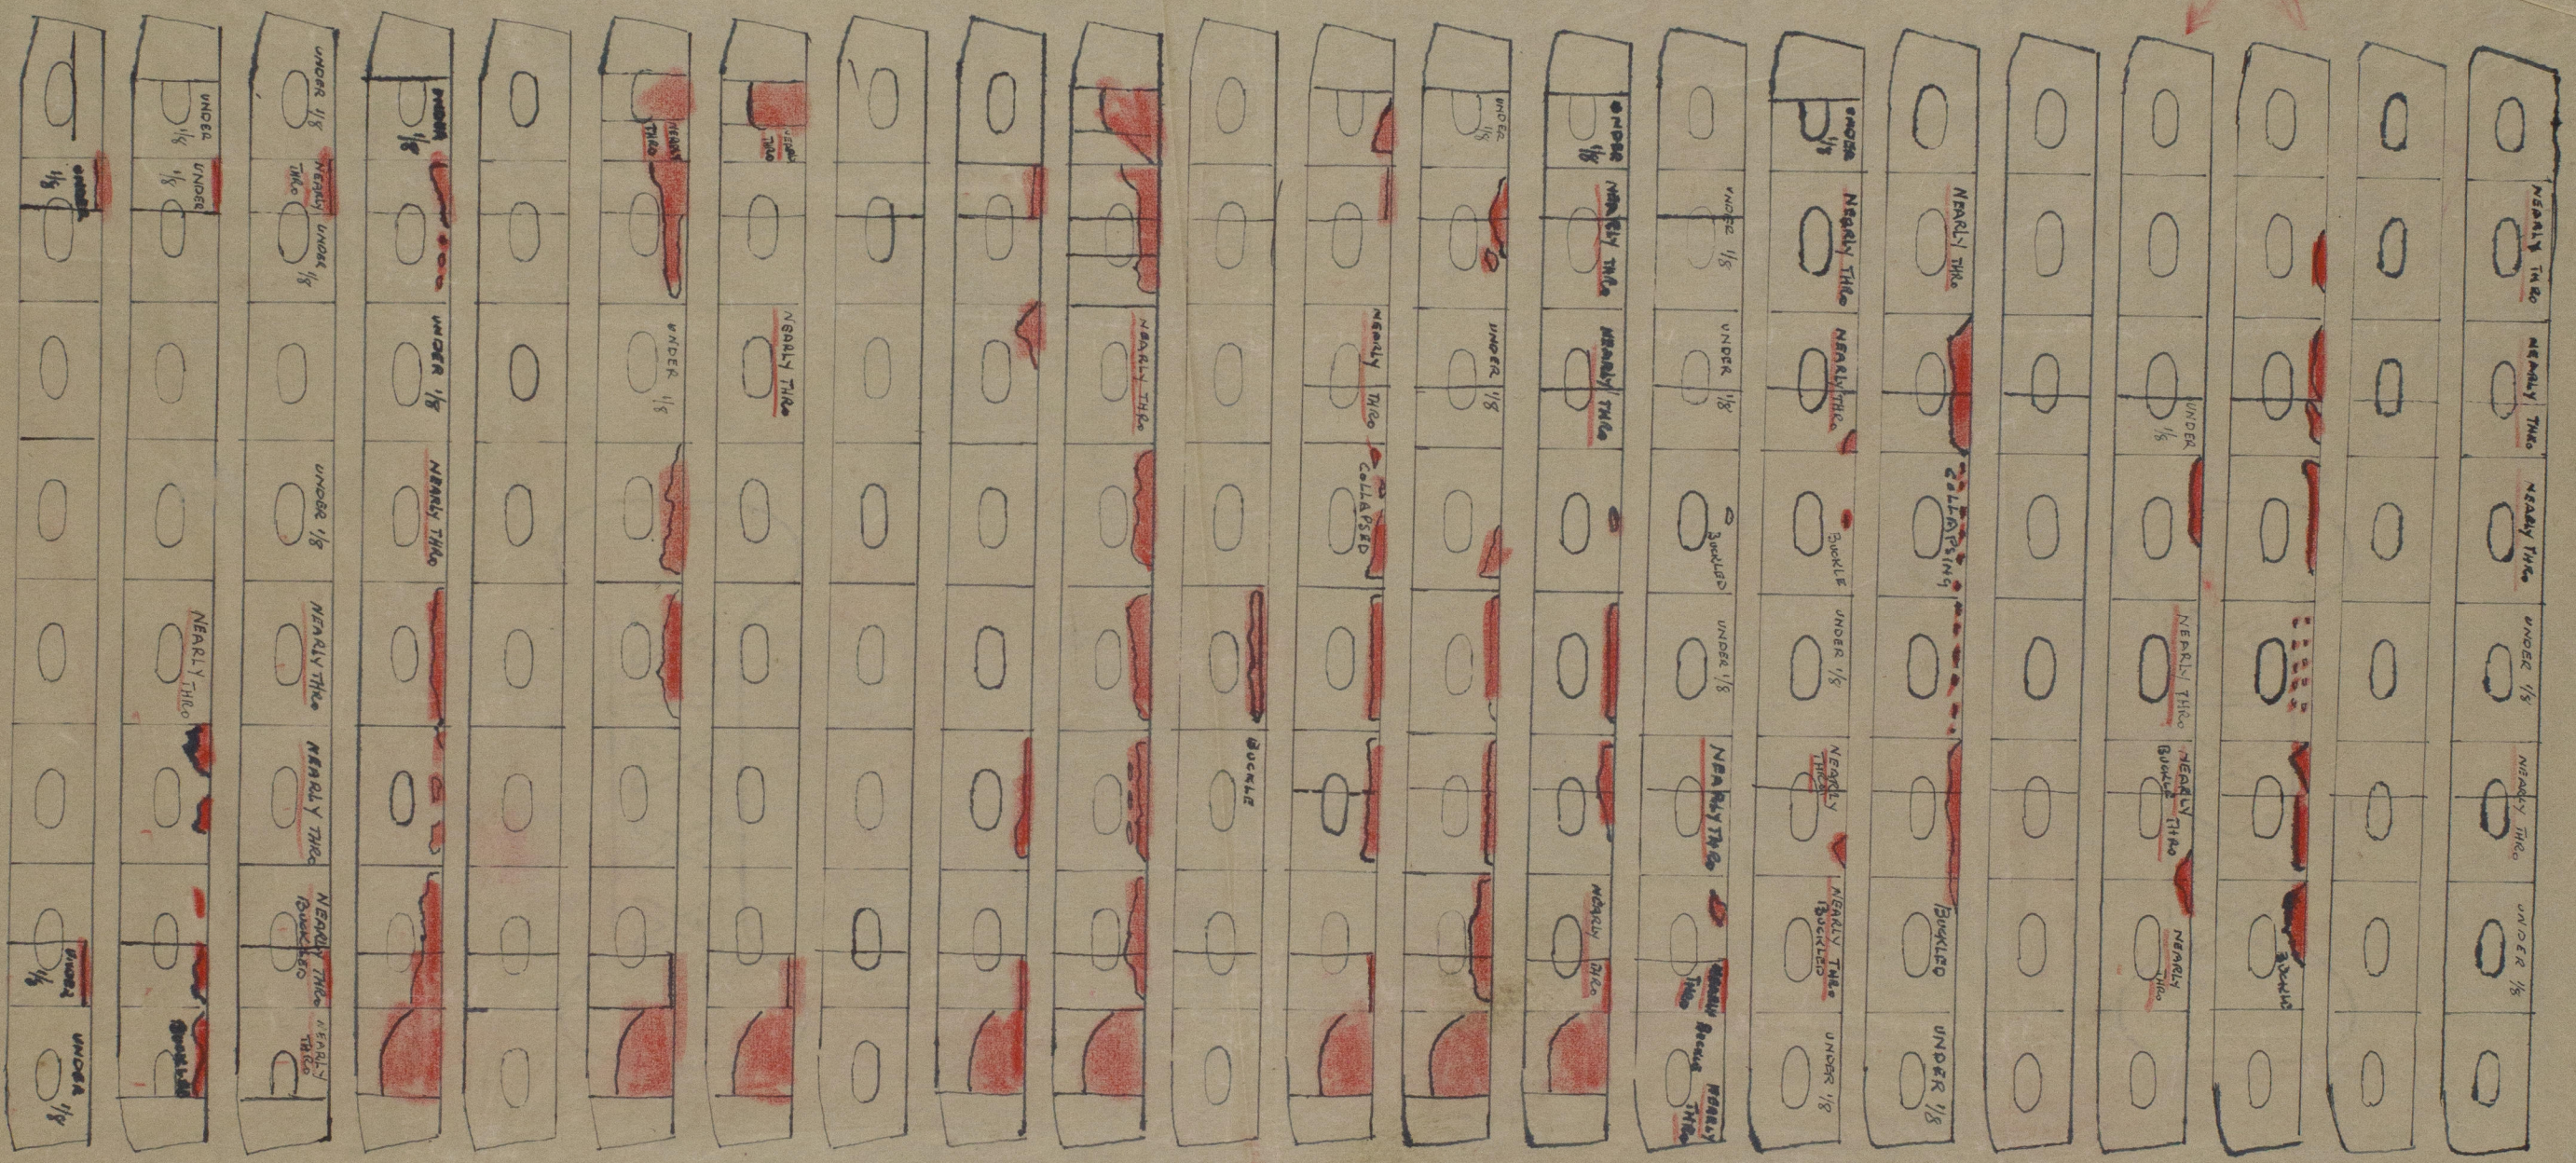

PORT SIDE

STARBOARD SIDE.

Suggested floor cropping & upper half removed
marked by X

PARTS SHOWN IN RED COMPLETELY GONE. ORIGINAL INTERCOSTALS IN A
SIMILAR CONDITION TO THE FLOORS. TANKTOP NOT YET CLEARED BUT OBSERVED
TO BE LEAKING FROM THE TOP IN 5 PLACES.



© 2020
Lloyd's Register
Foundation

L998-0026