

"S. S. Mount Edgcumbe"

Barrow Report No. 3679.

The Narrow Ship Building co. S. S. No. 112

Boilers nos 148 & 149



— Pressure 80 lbs per Sq inch —

Longitudinal seams, double rivetted, lap joints,
1 1/8" rivets, 4" pitch, drilled holes

HUTSON, & CORBETT,
KELVINHAUGH ENGINE WORKS,
GLASGOW.

— 28th Feby 83 —

Scale 1" = 1 foot

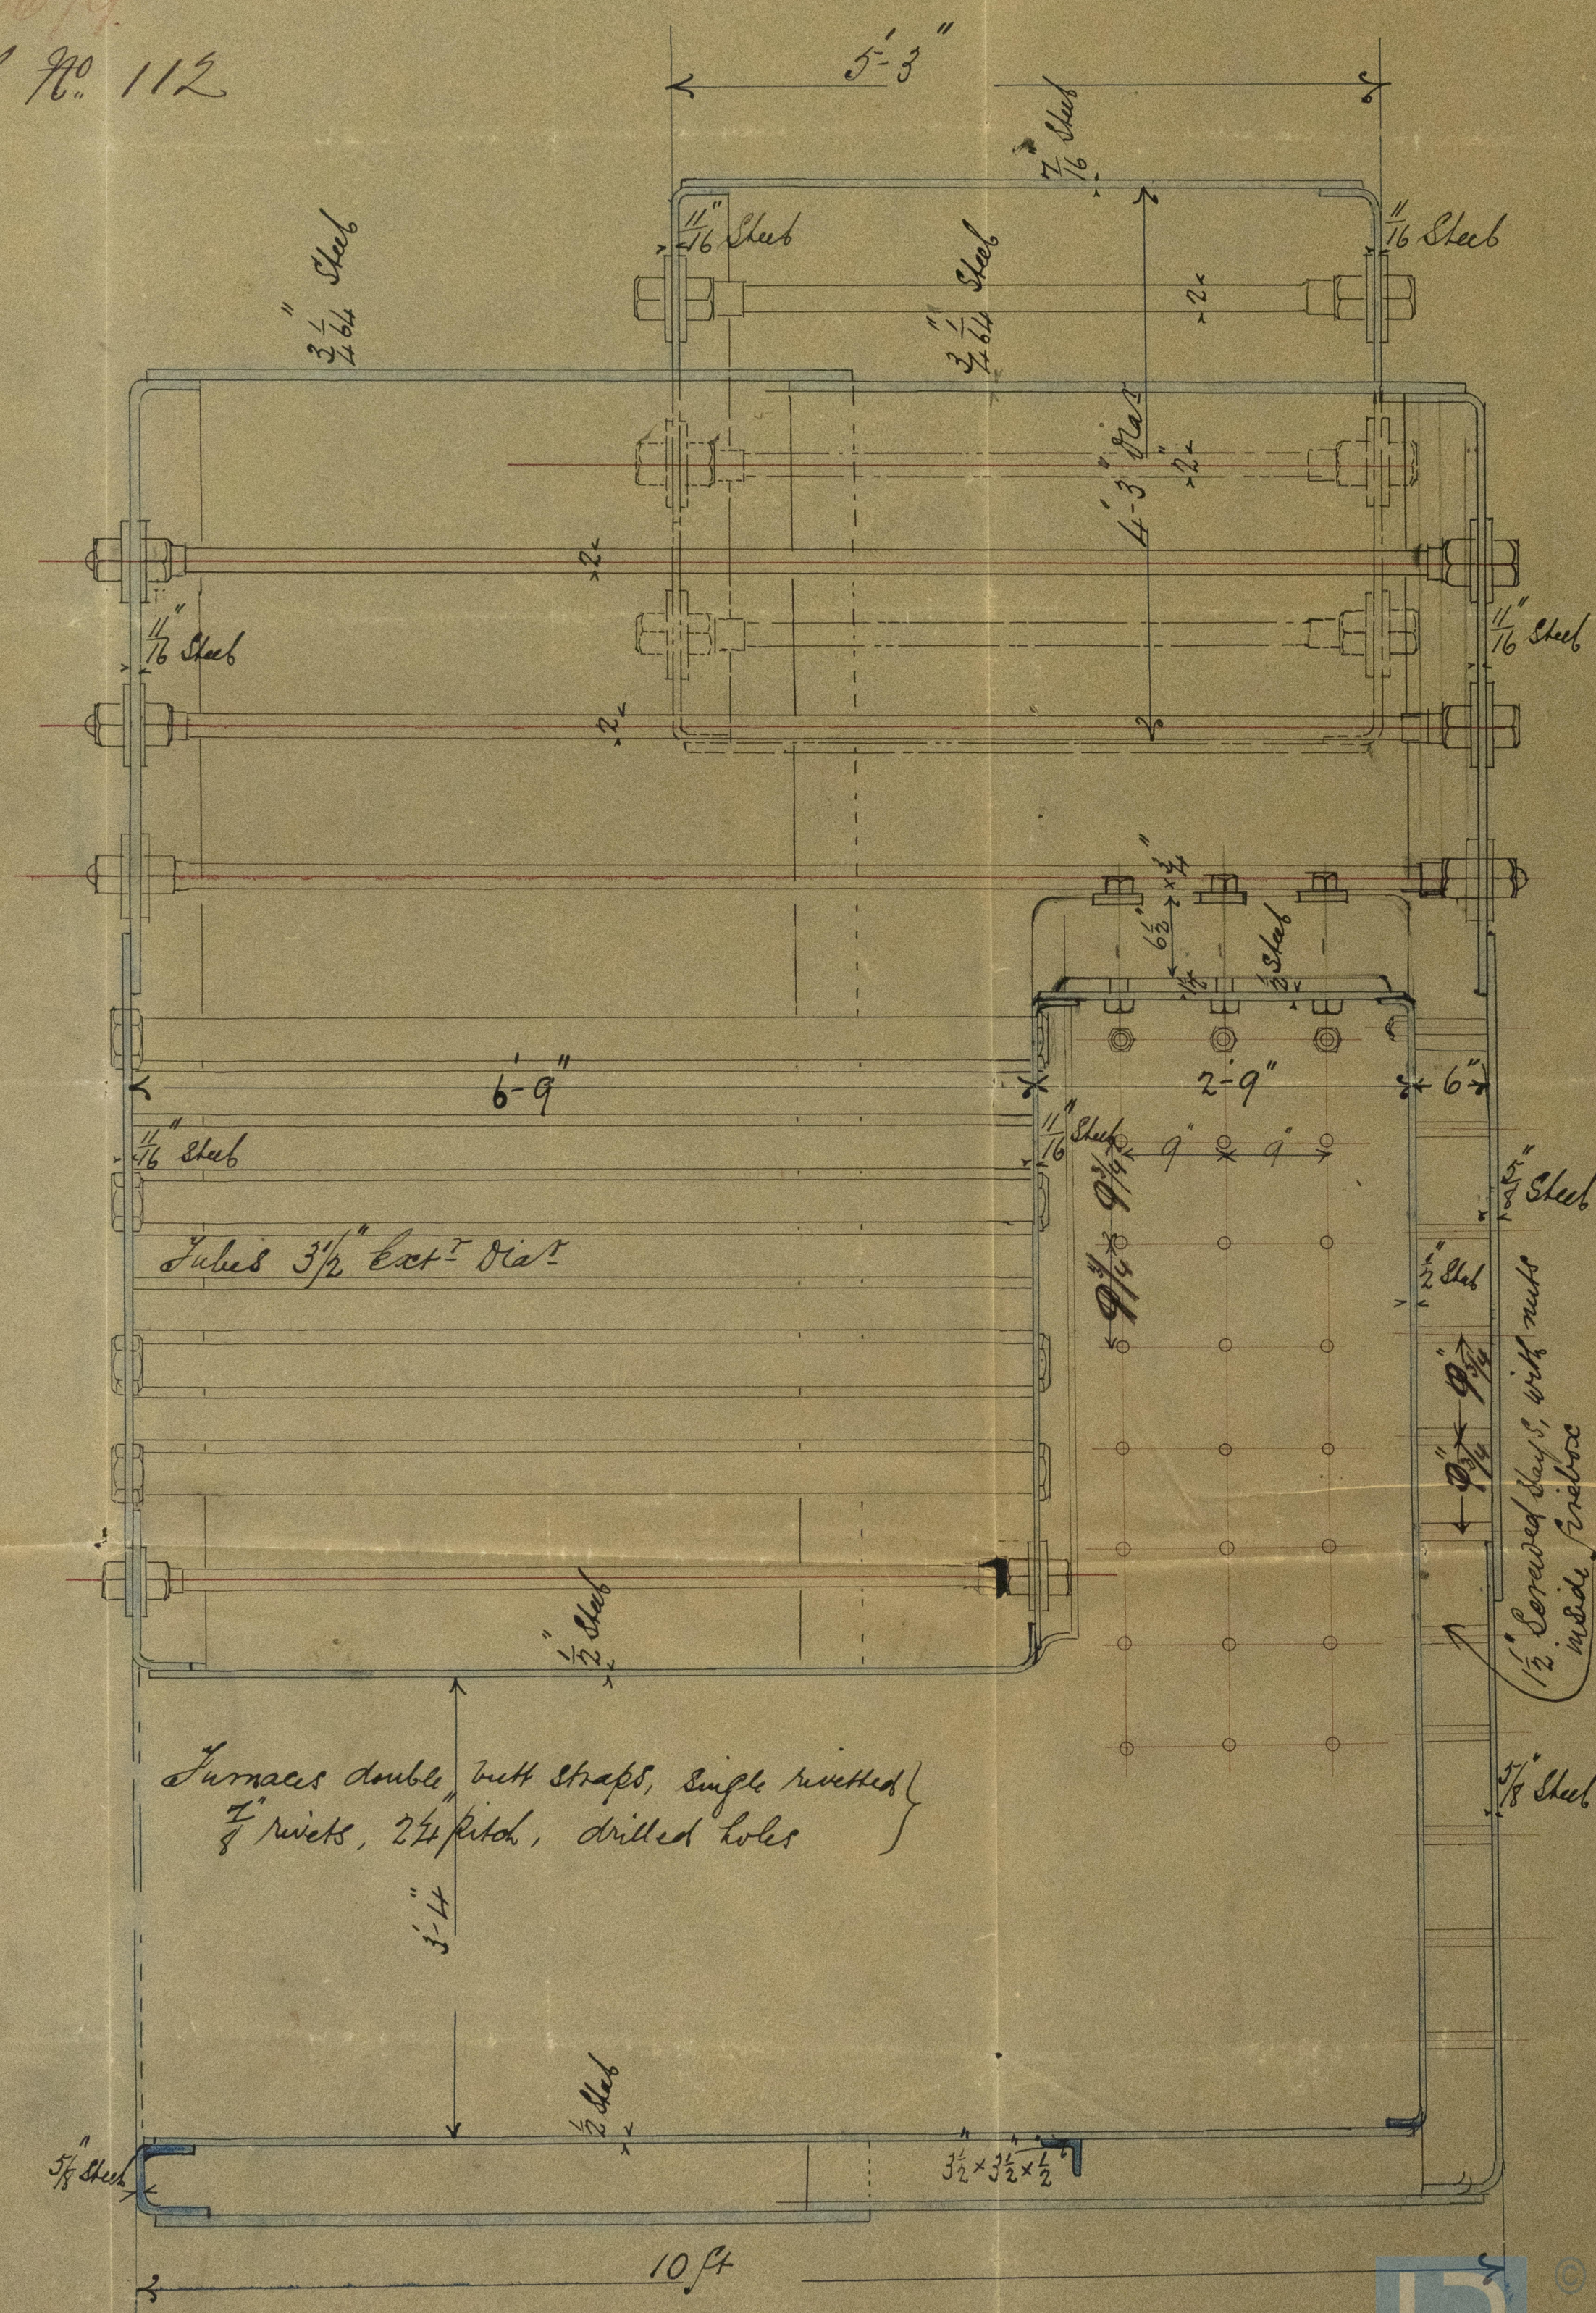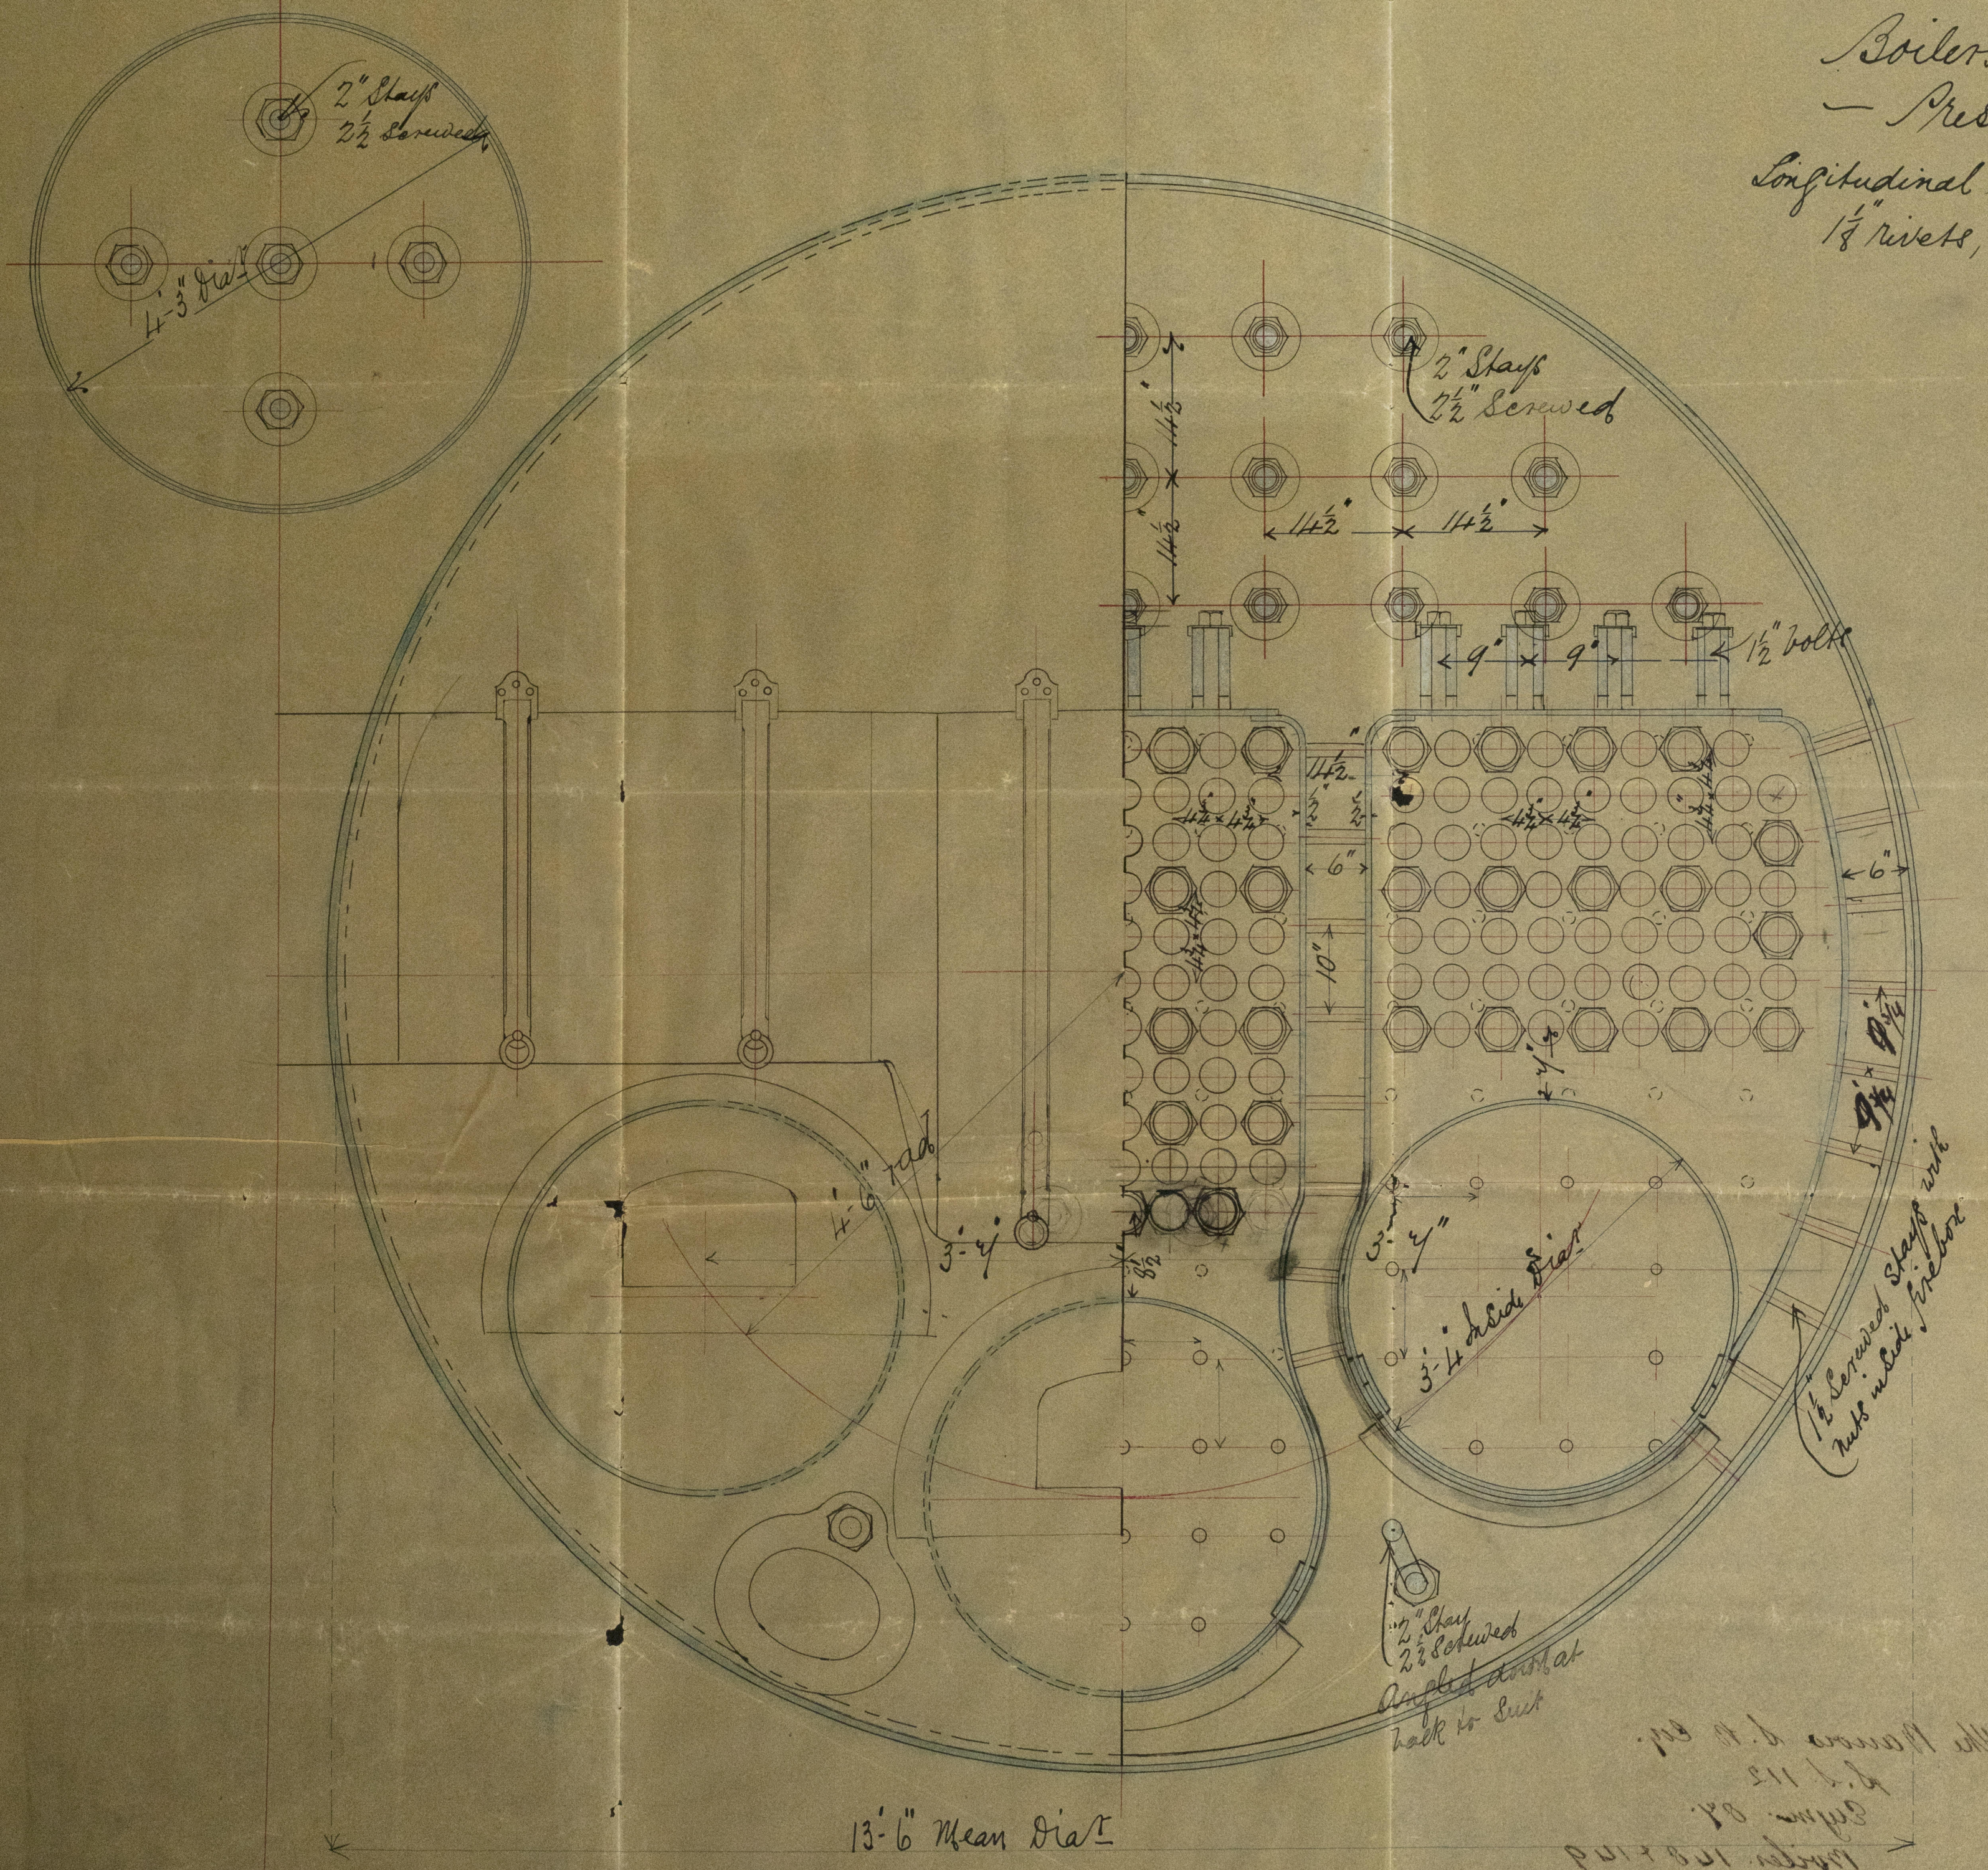

P. M. G.

5/3/83

Clyde District






The Manor S. B. Co.
S. S. 112
Eym. 84.
miles. 148 + 149



© 2021
Lloyd's Register
Foundation