

LLOYD'S REGISTER  
SHIP BUILDERS  
WORKS

Tracing No. 39



WILLIAMSON & CO  
SHIP BUILDERS  
WORKS

June 14<sup>th</sup> 1888

S. S. "Derwent"  
Wm report No. 3708

# Pumping Arrangement No. 80

Scale  $\frac{1}{2}$  inch = 1 foot

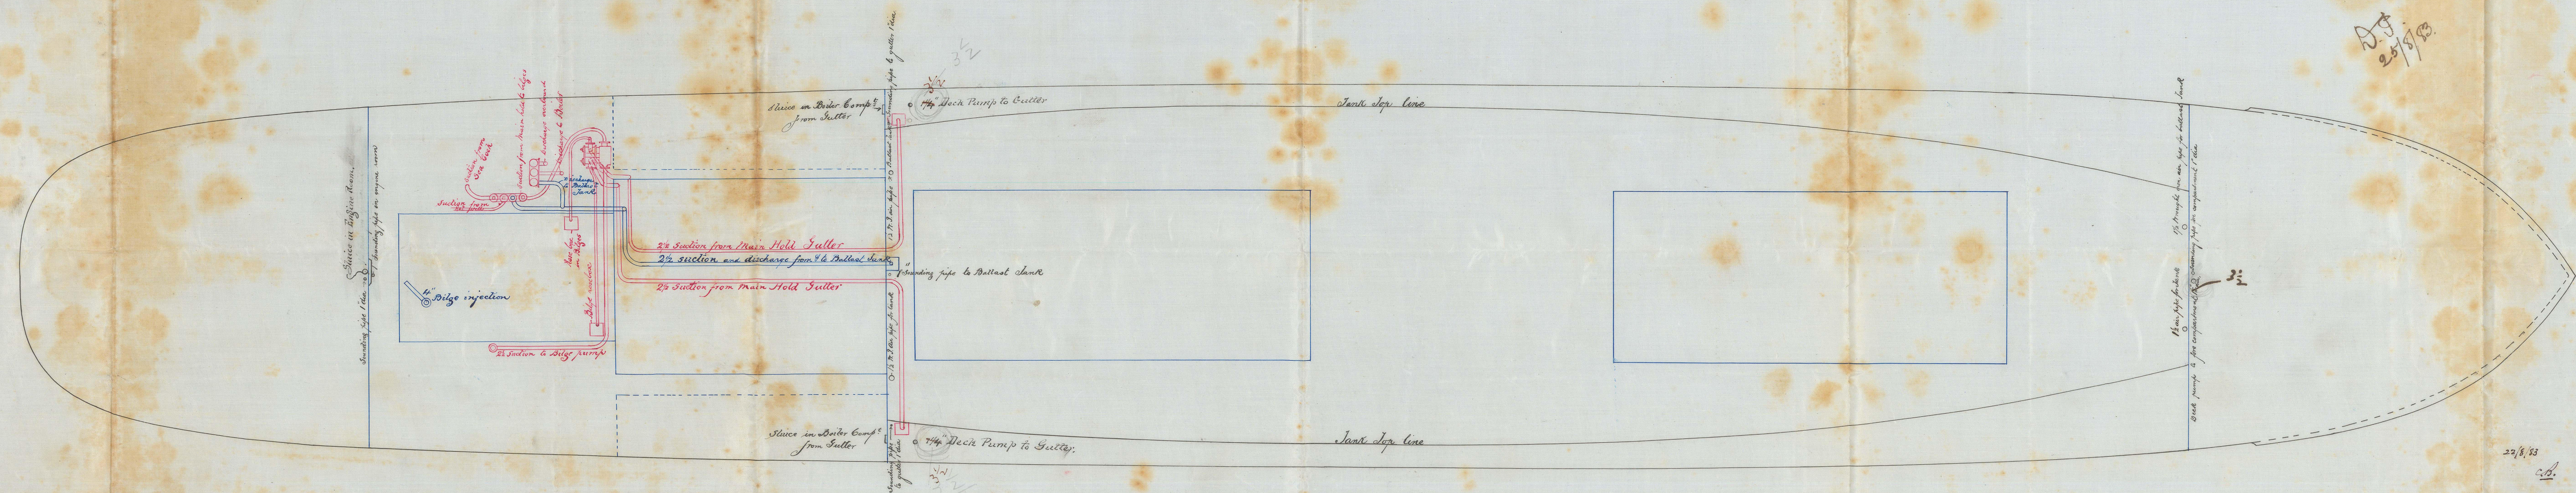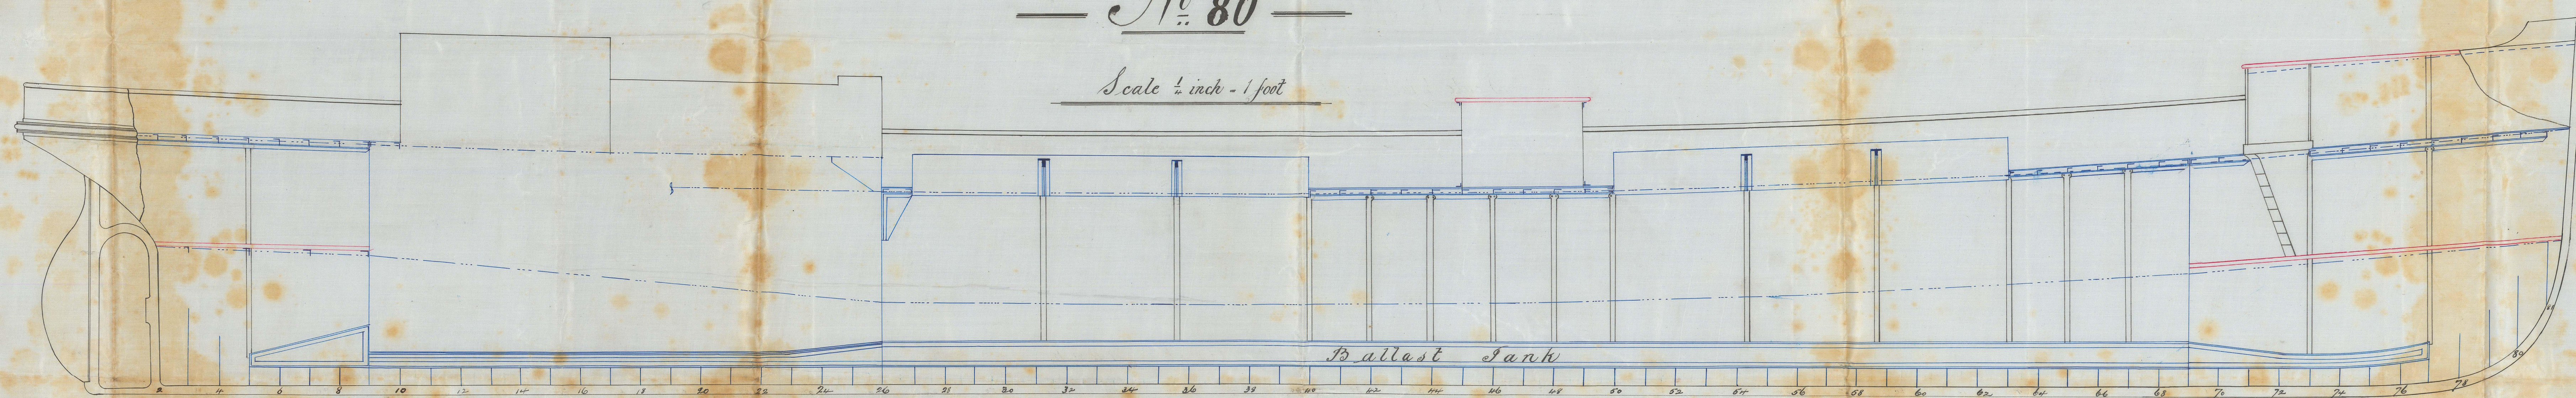

25/9/88

29/8/88

WILLIAMSON & CO