

RECEIVED 100 MAR. 82.



Tracing No 2
20th Dec 1883

Lt. L. Wm.
15/3/83

RECEIVED
20 OCT. 83
LONDON

PROFILE & DECK PLAN
No 80
Scale 1/4 Inch to the Foot

S.S. "Derwent"
Wm report No. 3708.

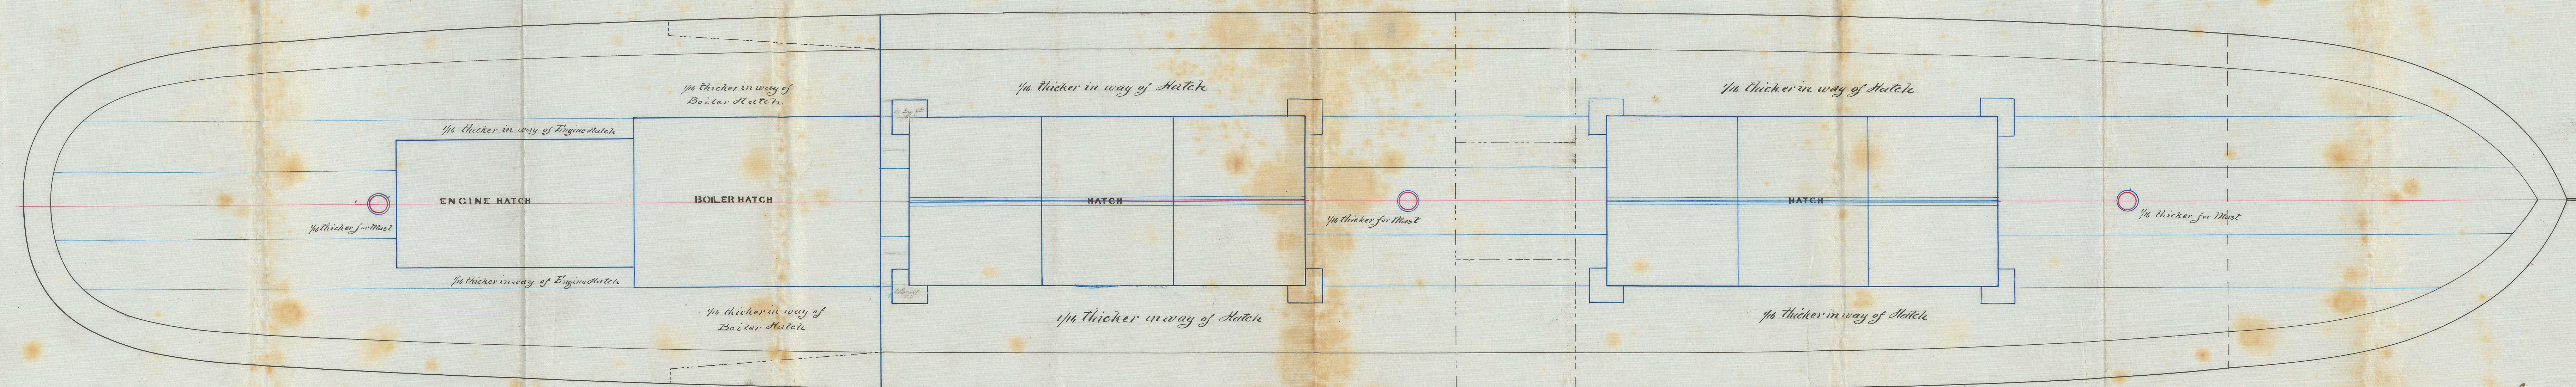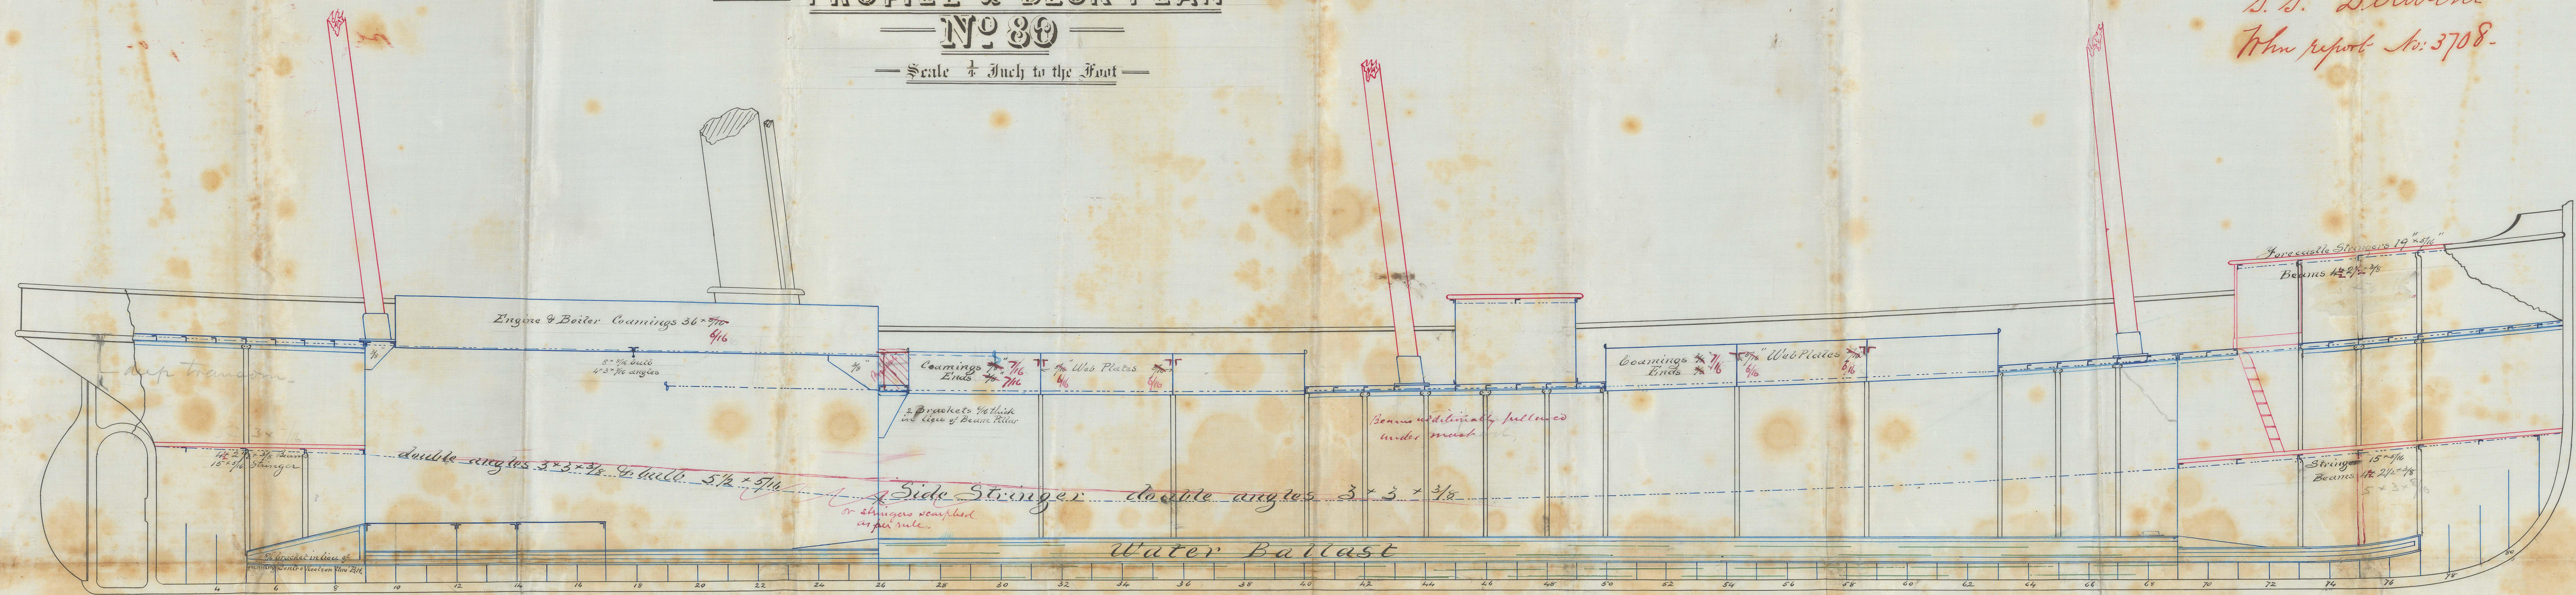

14/3/83

13/3/83

W.H.W. 1037-0070

RECEIVED
20 OCT. 83
LONDON

Lloyd's Register
Foundation