

Lloyd's Register of British and Foreign Shipping.

(Report on Vessel No. 3885 Port Whitehaven)

No. 694a. SHIP FORGINGS OR CASTINGS.

I have to report that the undermentioned Iron ~~or Steel~~ Forgings ~~or Castings~~, manufactured by the Darlington Forge Co of Darlington for the Vessel No. 68, being built by the Whitehaven S B Co of Whitehaven have been inspected by me as set forth below, and found to be, so far as can be seen, sound.

The words FORGINGS or CASTINGS, IRON or STEEL, should be struck out as may be required.

Mark on Forgings.


Lloyd's
No. 694a
No. 6

Hugh Cameron

Sunderland
7/12/84

	STERN FRAME.	RUDDER FRAME.	STEM.
Material*	<u>Scrap iron</u>	<u>Scrap iron</u>	<u>Scrap iron</u>
How made	<u>Forged</u>	<u>Forged</u>	<u>Forged</u>
Dimensions	<u>9 x 5 1/2</u>	<u>7 x 3 1/2</u>	<u>9 x 2 1/2</u>
Progress on Inspection	<u>Forged & Smithed</u>	<u>Forged & Smithed</u>	<u>Forged & Machine'd</u>
Dates when Inspected	<u>Oct 3-7-13-14-22/84</u>	<u>Nov 1-5-11-16-19-24-28/84</u>	<u>Nov 1-16/84</u>

SKETCHES OF FRAMES SHEWING POSITION AND DESCRIPTION OF WELDS OF FORGINGS, OR PARTICULARS OF TESTS APPLIED TO CASTINGS.

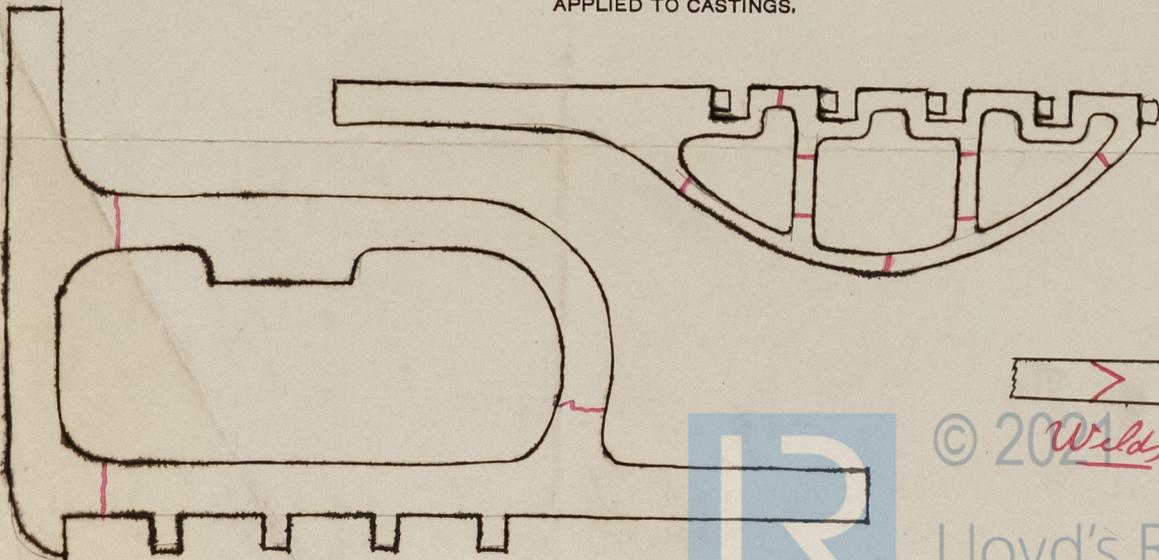

Welds

© 2021

Lloyd's Register
Foundation