


Arrangement of  
Strong beams, web frames, & deck plating &c  
in way of Engine & Boiler space.  
Scale  $\frac{1}{4}" = 1 \text{ foot}$ .

Steel S.S. "Tropic" Mm. Rep. No. 3885.


24.10.87



MAIN DECK PLAN.

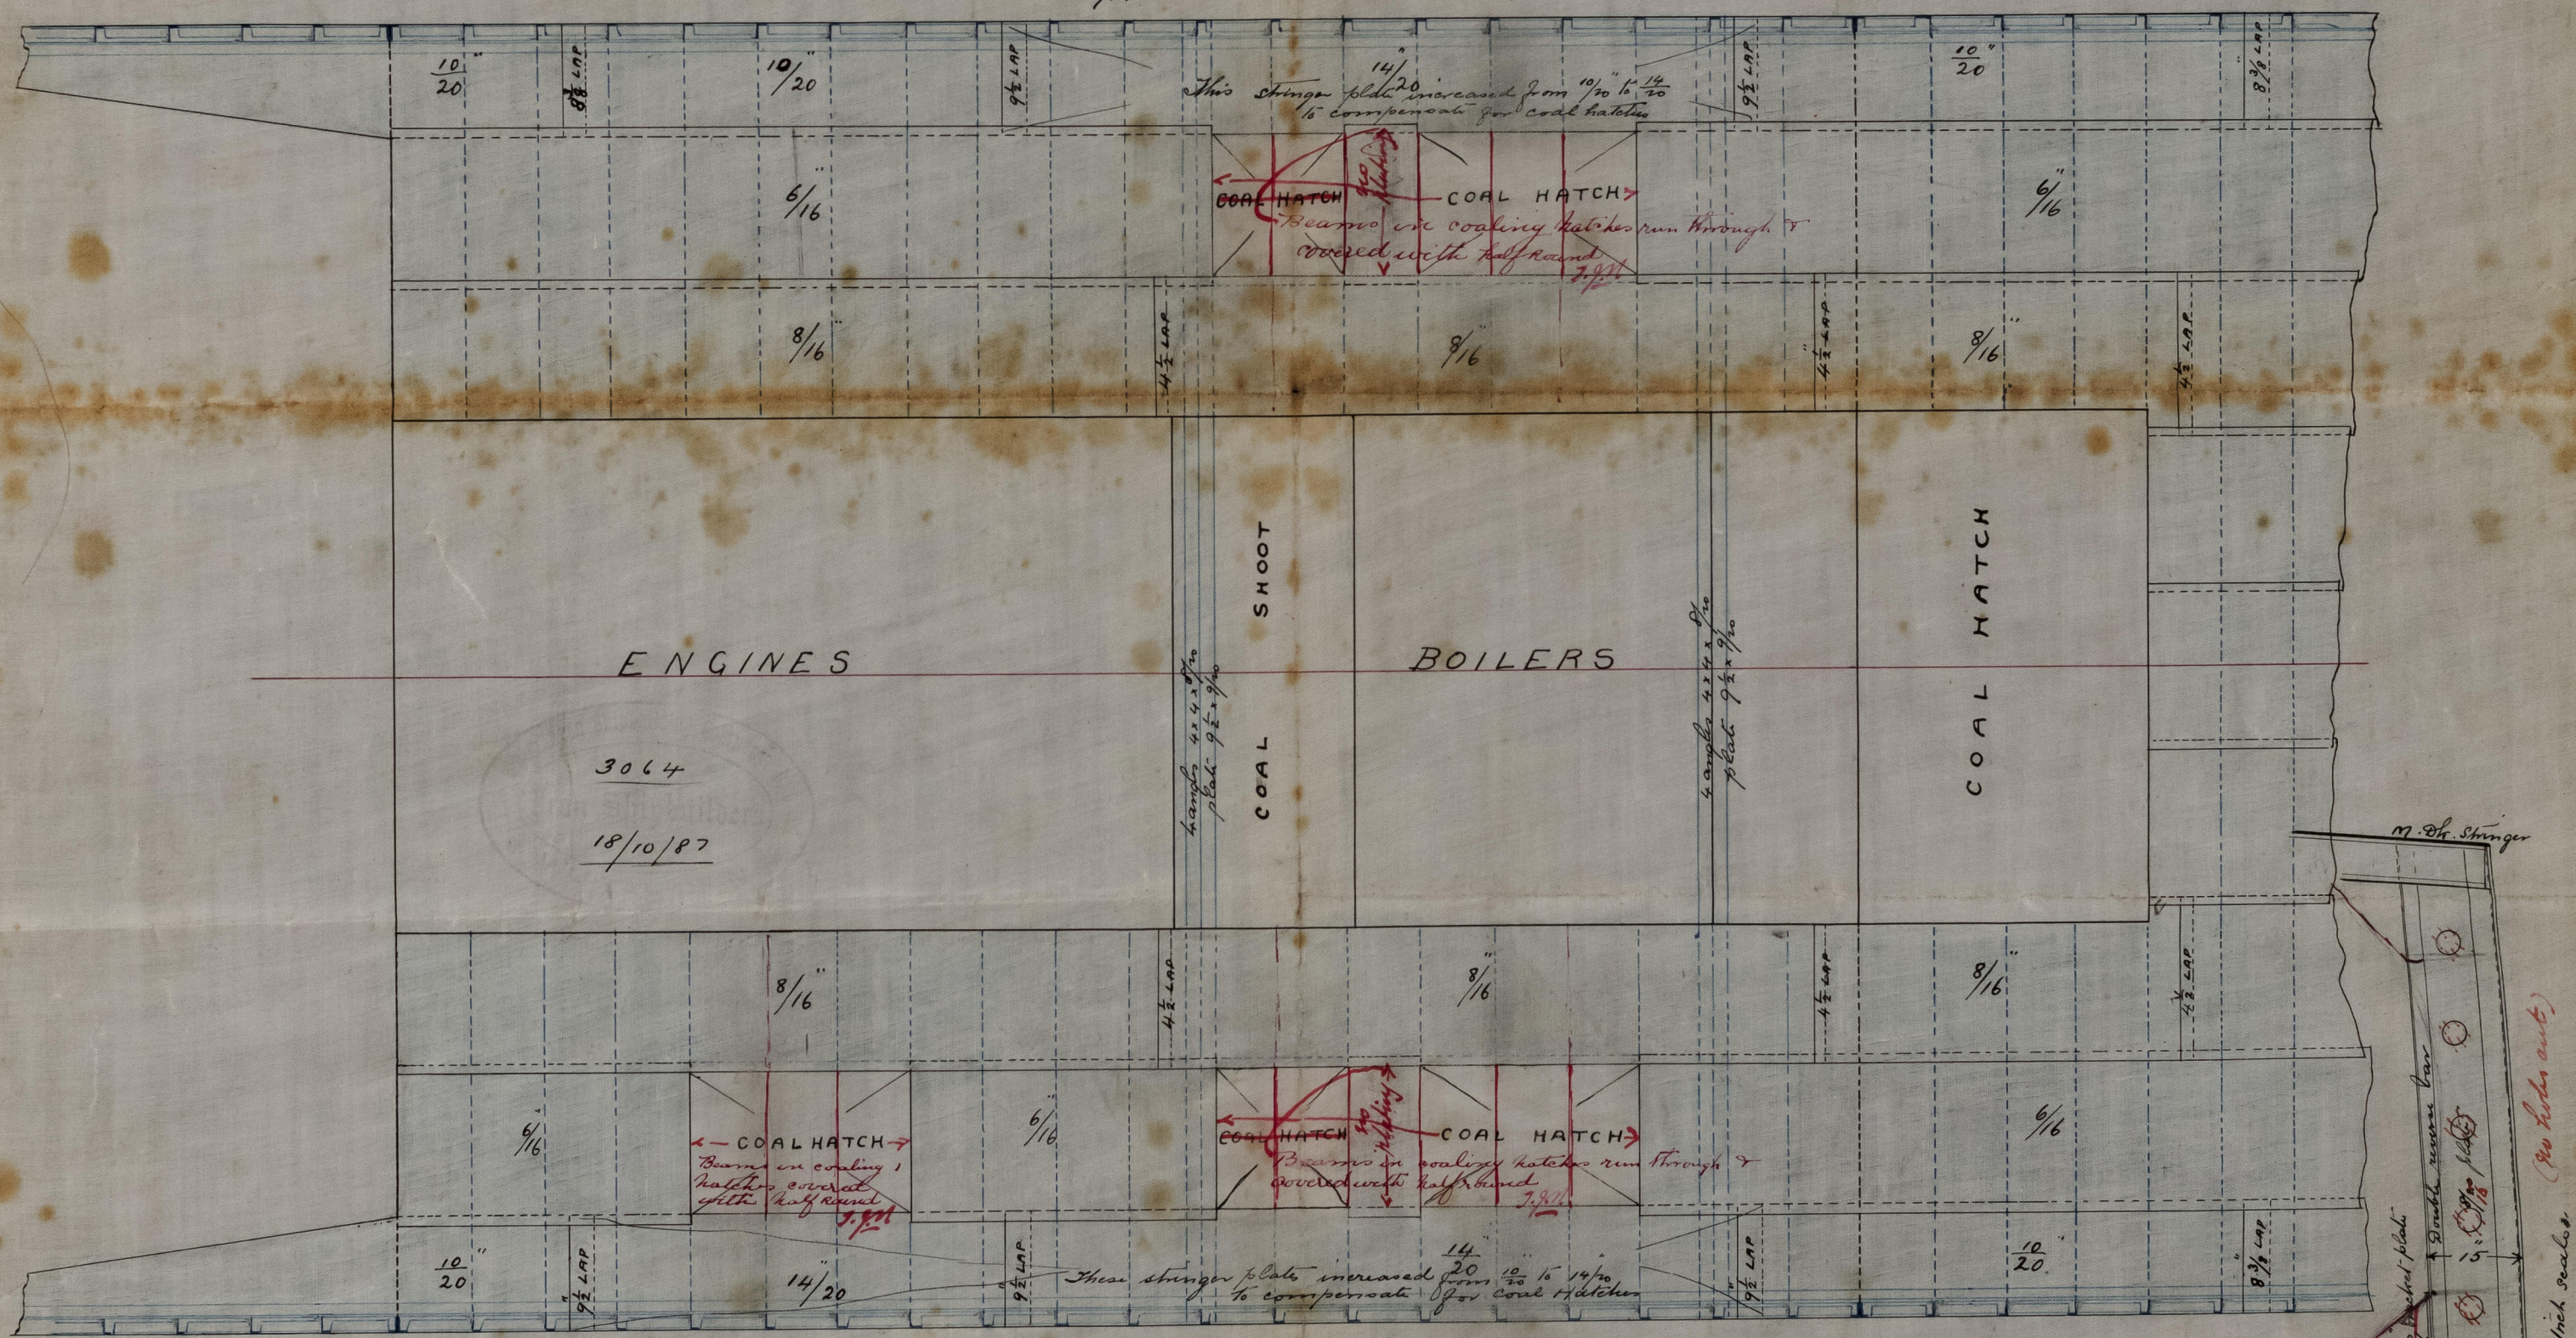

LOWER DECK STRINGER PLAN.

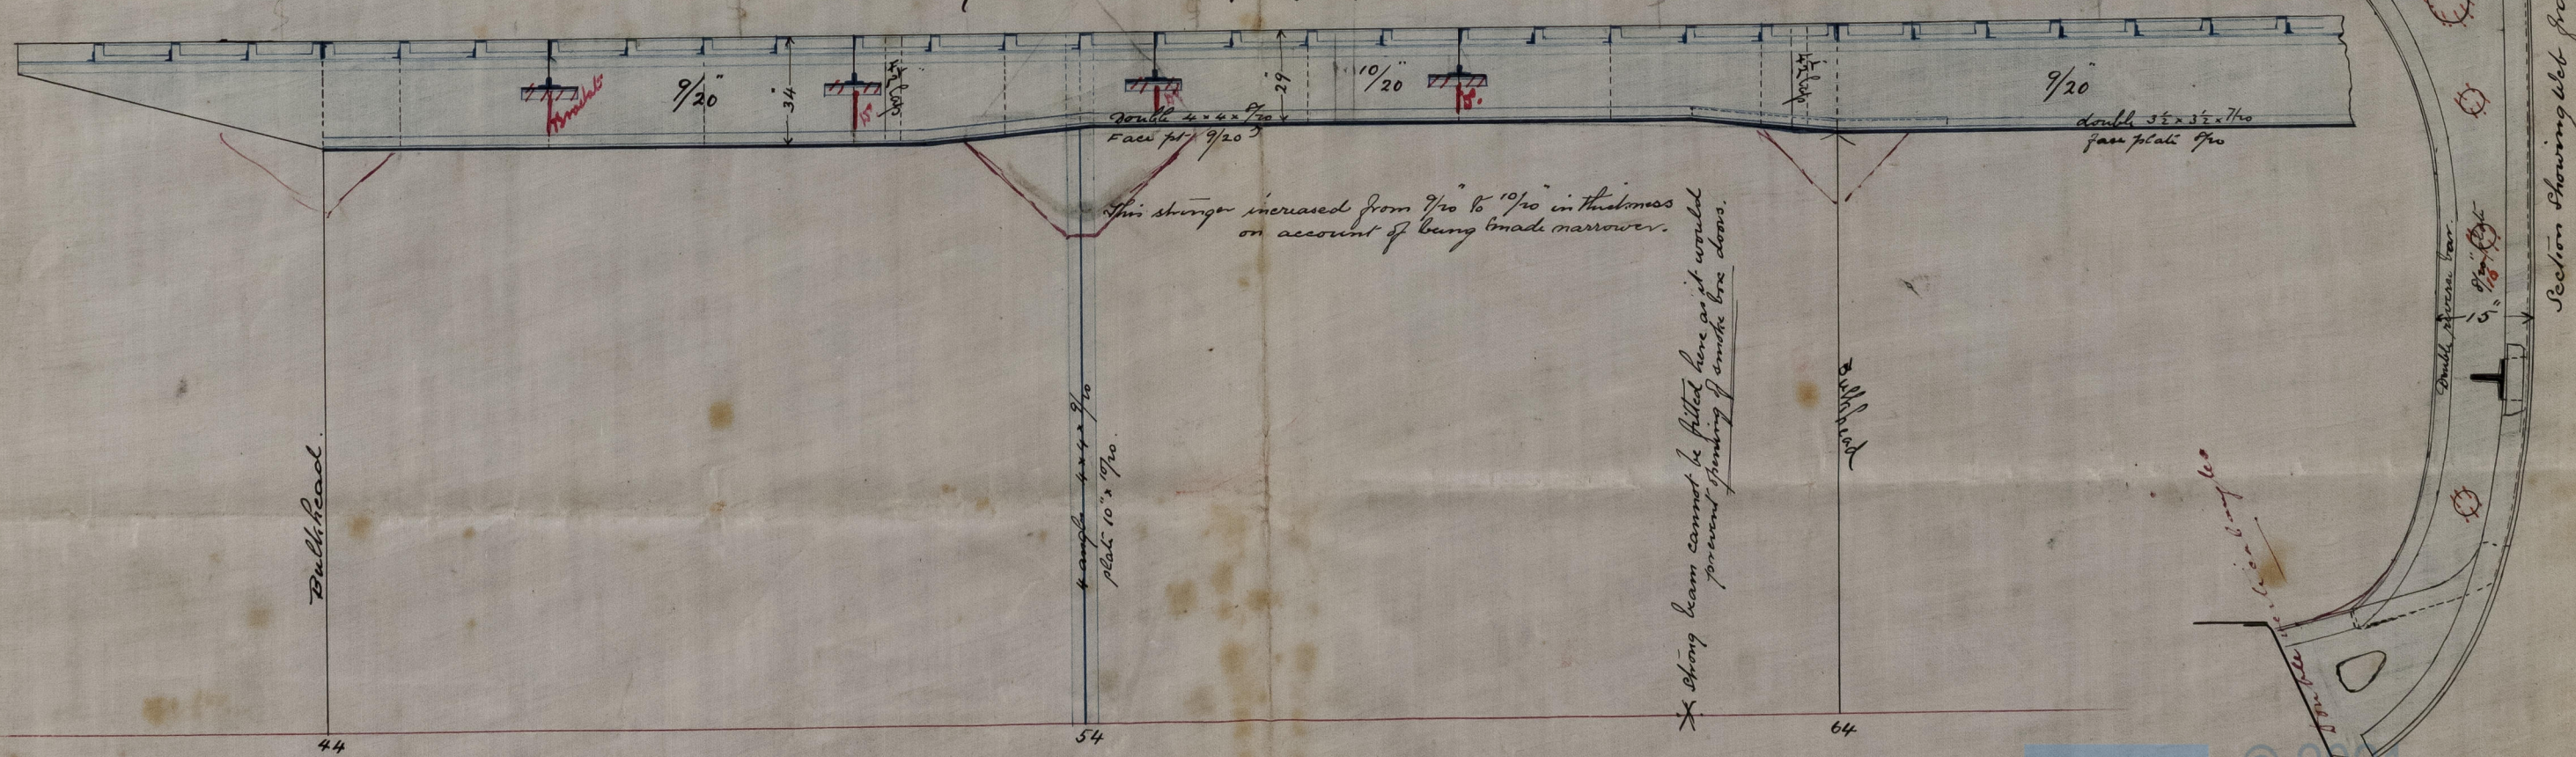

W.H.N. 1039-0016


22/10/87



© 2021  
Lloyd's Register  
Foundation



Ms. 10.21

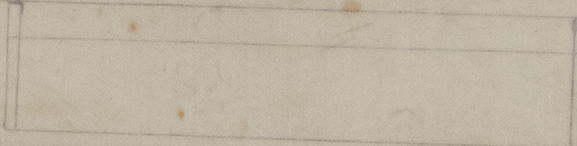

WHN1039-0016



© 2021

Lloyd's Register  
Foundation